


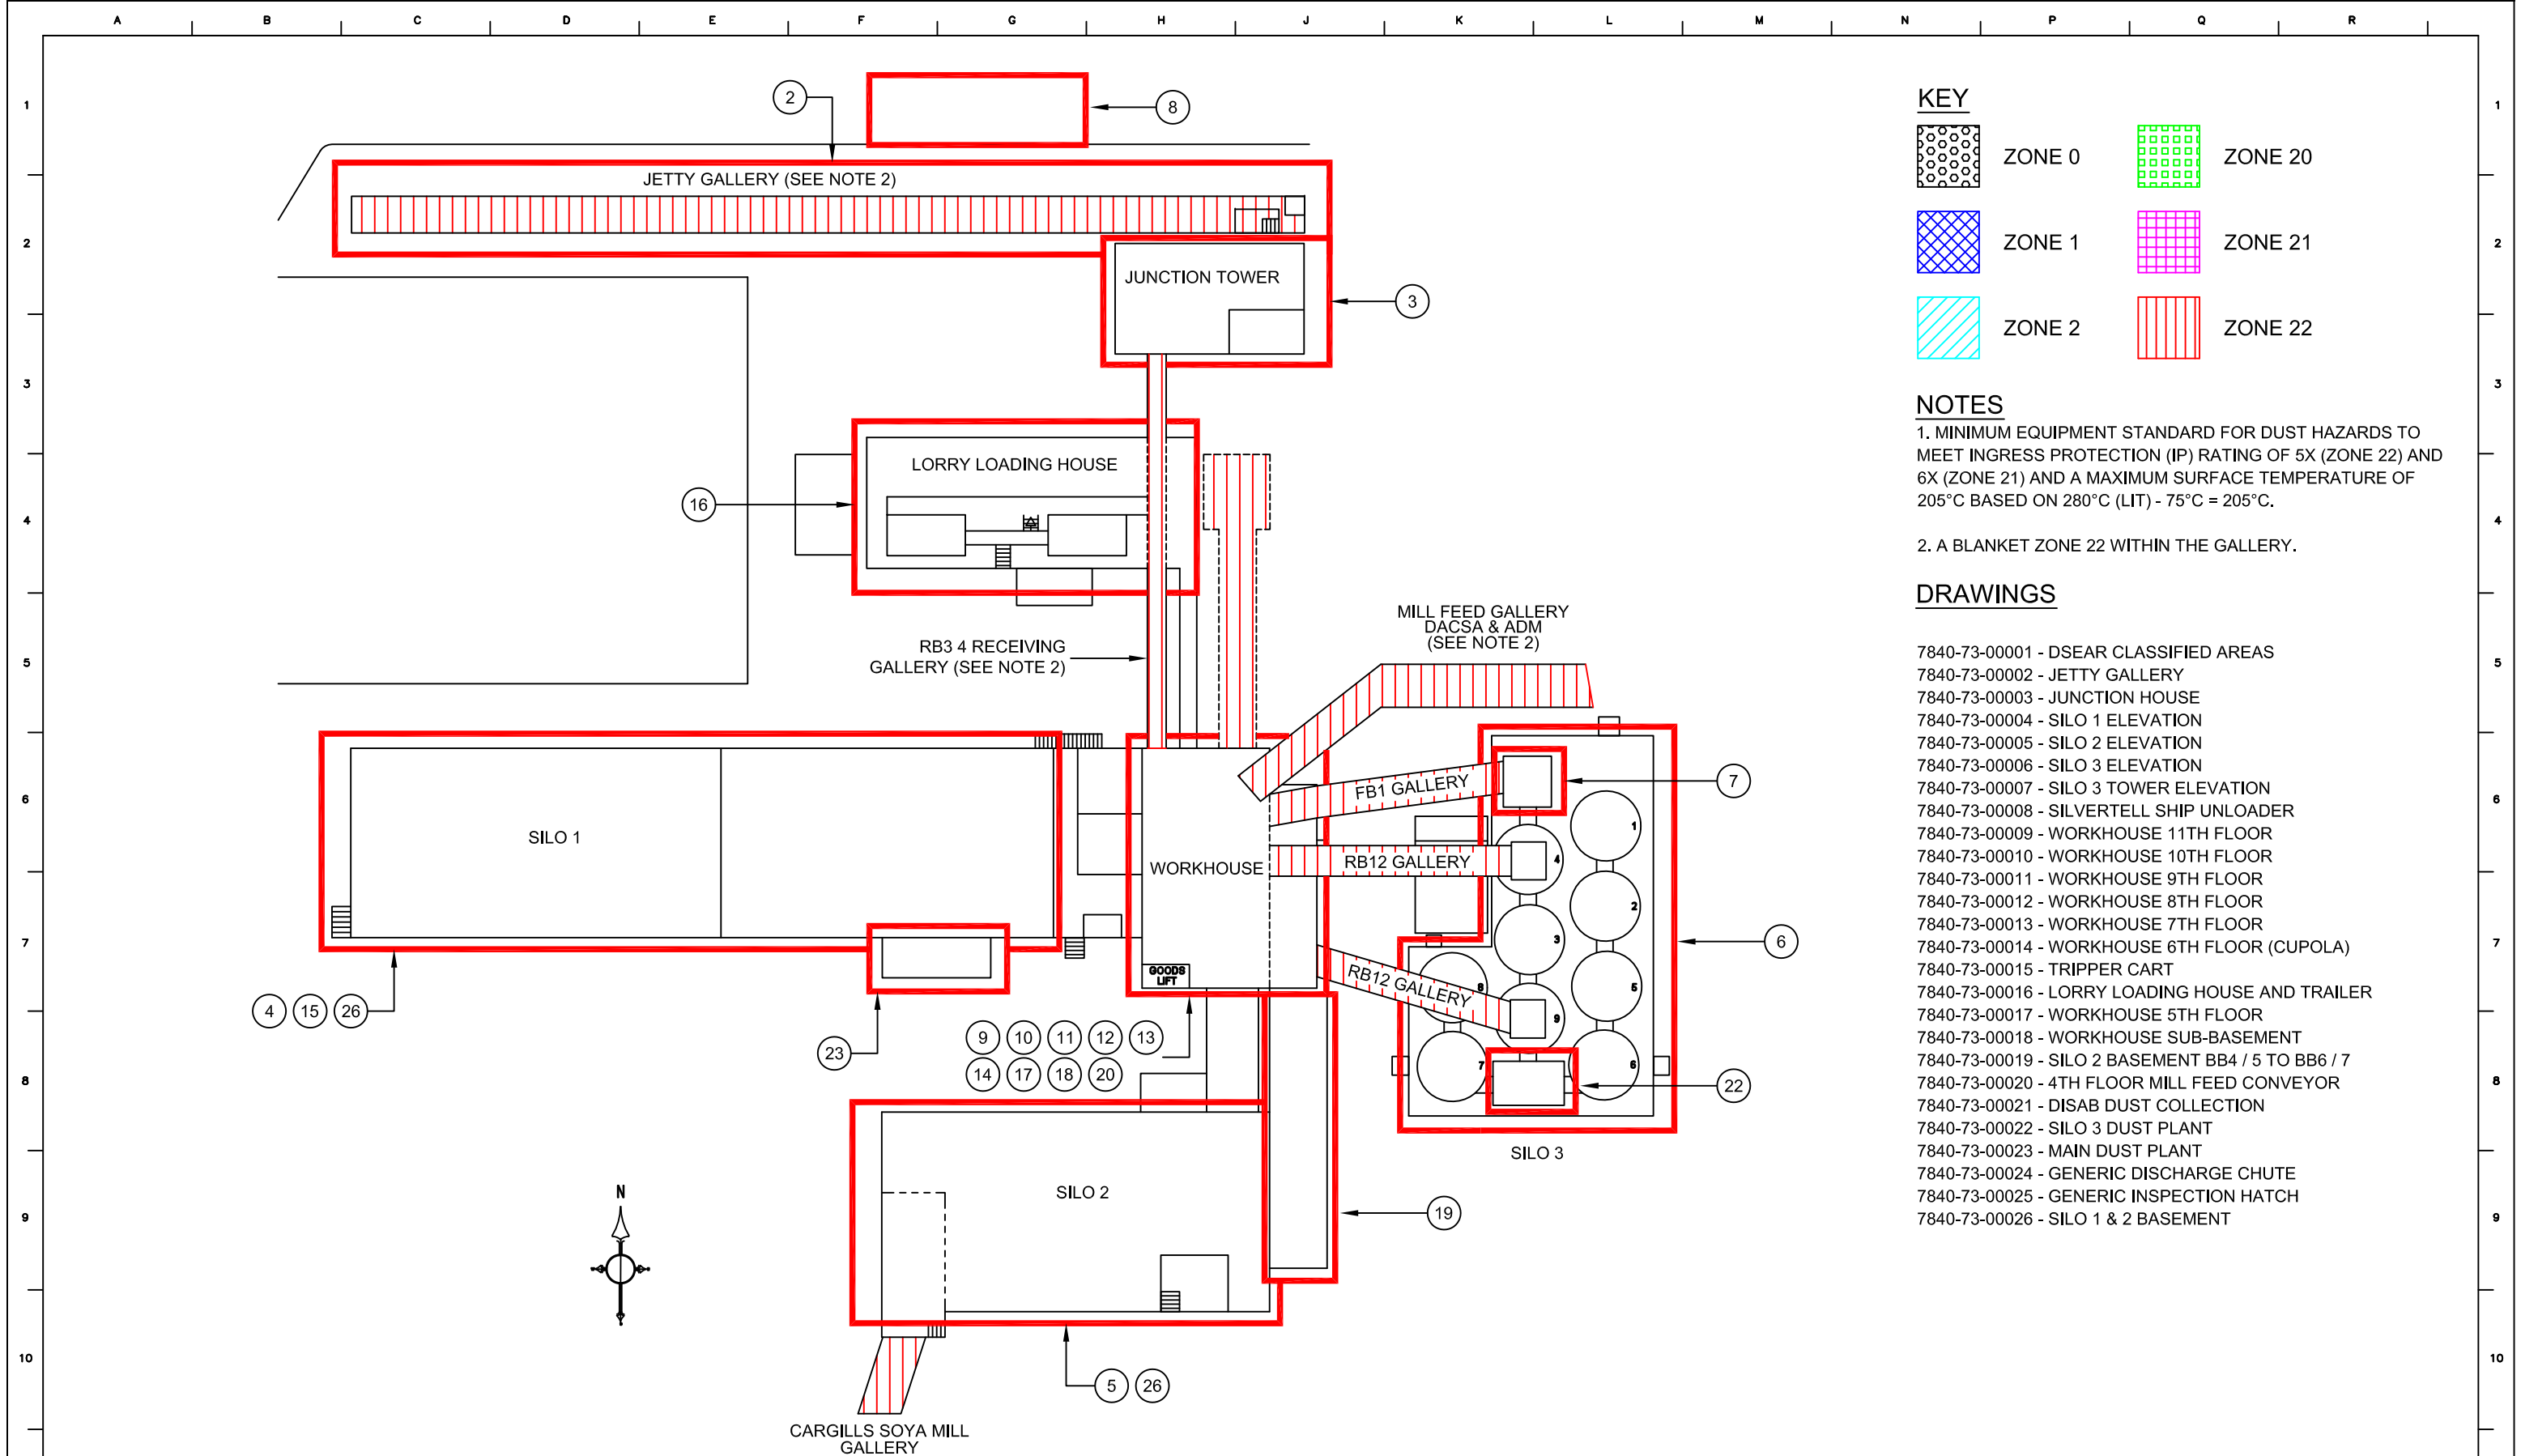

KEY

ZONE 0

ZONE 1

ZONE 2

ZONE 20

ZONE 21

ZONE 22

NOTES

1. MINIMUM EQUIPMENT STANDARD FOR DUST HAZARDS TO MEET INGRESS PROTECTION (IP) RATING OF 5X (ZONE 22) AND 6X (ZONE 21) AND A MAXIMUM SURFACE TEMPERATURE OF 205°C BASED ON 280°C (LIT) - 75°C = 205°C.

2. A BLANKET ZONE 22 WITHIN THE GALLERY.

DRAWINGS

- 7840-73-00001 - DSEAR CLASSIFIED AREAS
- 7840-73-00002 - JETTY GALLERY
- 7840-73-00003 - JUNCTION HOUSE
- 7840-73-00004 - SILO 1 ELEVATION
- 7840-73-00005 - SILO 2 ELEVATION
- 7840-73-00006 - SILO 3 ELEVATION
- 7840-73-00007 - SILO 3 TOWER ELEVATION
- 7840-73-00008 - SILVERTELL SHIP UNLOADER
- 7840-73-00009 - WORKHOUSE 11TH FLOOR
- 7840-73-00010 - WORKHOUSE 10TH FLOOR
- 7840-73-00011 - WORKHOUSE 9TH FLOOR
- 7840-73-00012 - WORKHOUSE 8TH FLOOR
- 7840-73-00013 - WORKHOUSE 7TH FLOOR
- 7840-73-00014 - WORKHOUSE 6TH FLOOR (CUPOLA)
- 7840-73-00015 - TRIPPER CART
- 7840-73-00016 - LORRY LOADING HOUSE AND TRAILER
- 7840-73-00017 - WORKHOUSE 5TH FLOOR
- 7840-73-00018 - WORKHOUSE SUB-BASEMENT
- 7840-73-00019 - SILO 2 BASEMENT BB4 / 5 TO BB6 / 7
- 7840-73-00020 - 4TH FLOOR MILL FEED CONVEYOR
- 7840-73-00021 - DISAB DUST COLLECTION
- 7840-73-00022 - SILO 3 DUST PLANT
- 7840-73-00023 - MAIN DUST PLANT
- 7840-73-00024 - GENERIC DISCHARGE CHUTE
- 7840-73-00025 - GENERIC INSPECTION HATCH
- 7840-73-00026 - SILO 1 & 2 BASEMENT

11	REVISION	A		 INGLEWOOD ENGINEERING CONSULTANCY LTD SYCAMORE HOUSE, SPRINGWOOD WAY, TYTHERINGTON BUSINESS PARK, MACCLESFIELD, CHESHIRE, SK10 2ND, 01625 410100 INFO@INGLEWOODENGINEERING.COM	PROJECT DSEAR AREA CLASSIFICATION			TITLE ROYAL SEAFORTH GRAIN TERMINAL DSEAR CLASSIFIED AREAS			11	
	DATE	20/10/20			IEC PROJECT No. 7840			DSEAR CLASSIFIED AREAS				
	DESCRIPTION	AS BUILT			IEC DRAWING No. 7840-73-00001							
AUTHOR		SDO			SCALE NTS @ A3	DRAWN	S. OWEN	DATE	20/10/20	DRAWING No. 7840-73-00001	SHT No. A	REV. A
CHECKED		SDO				CHECKED	S. OWEN	DATE	20/10/20			
APPROVED		AW				APPROVED	A. WOOD	DATE	20/10/20			