
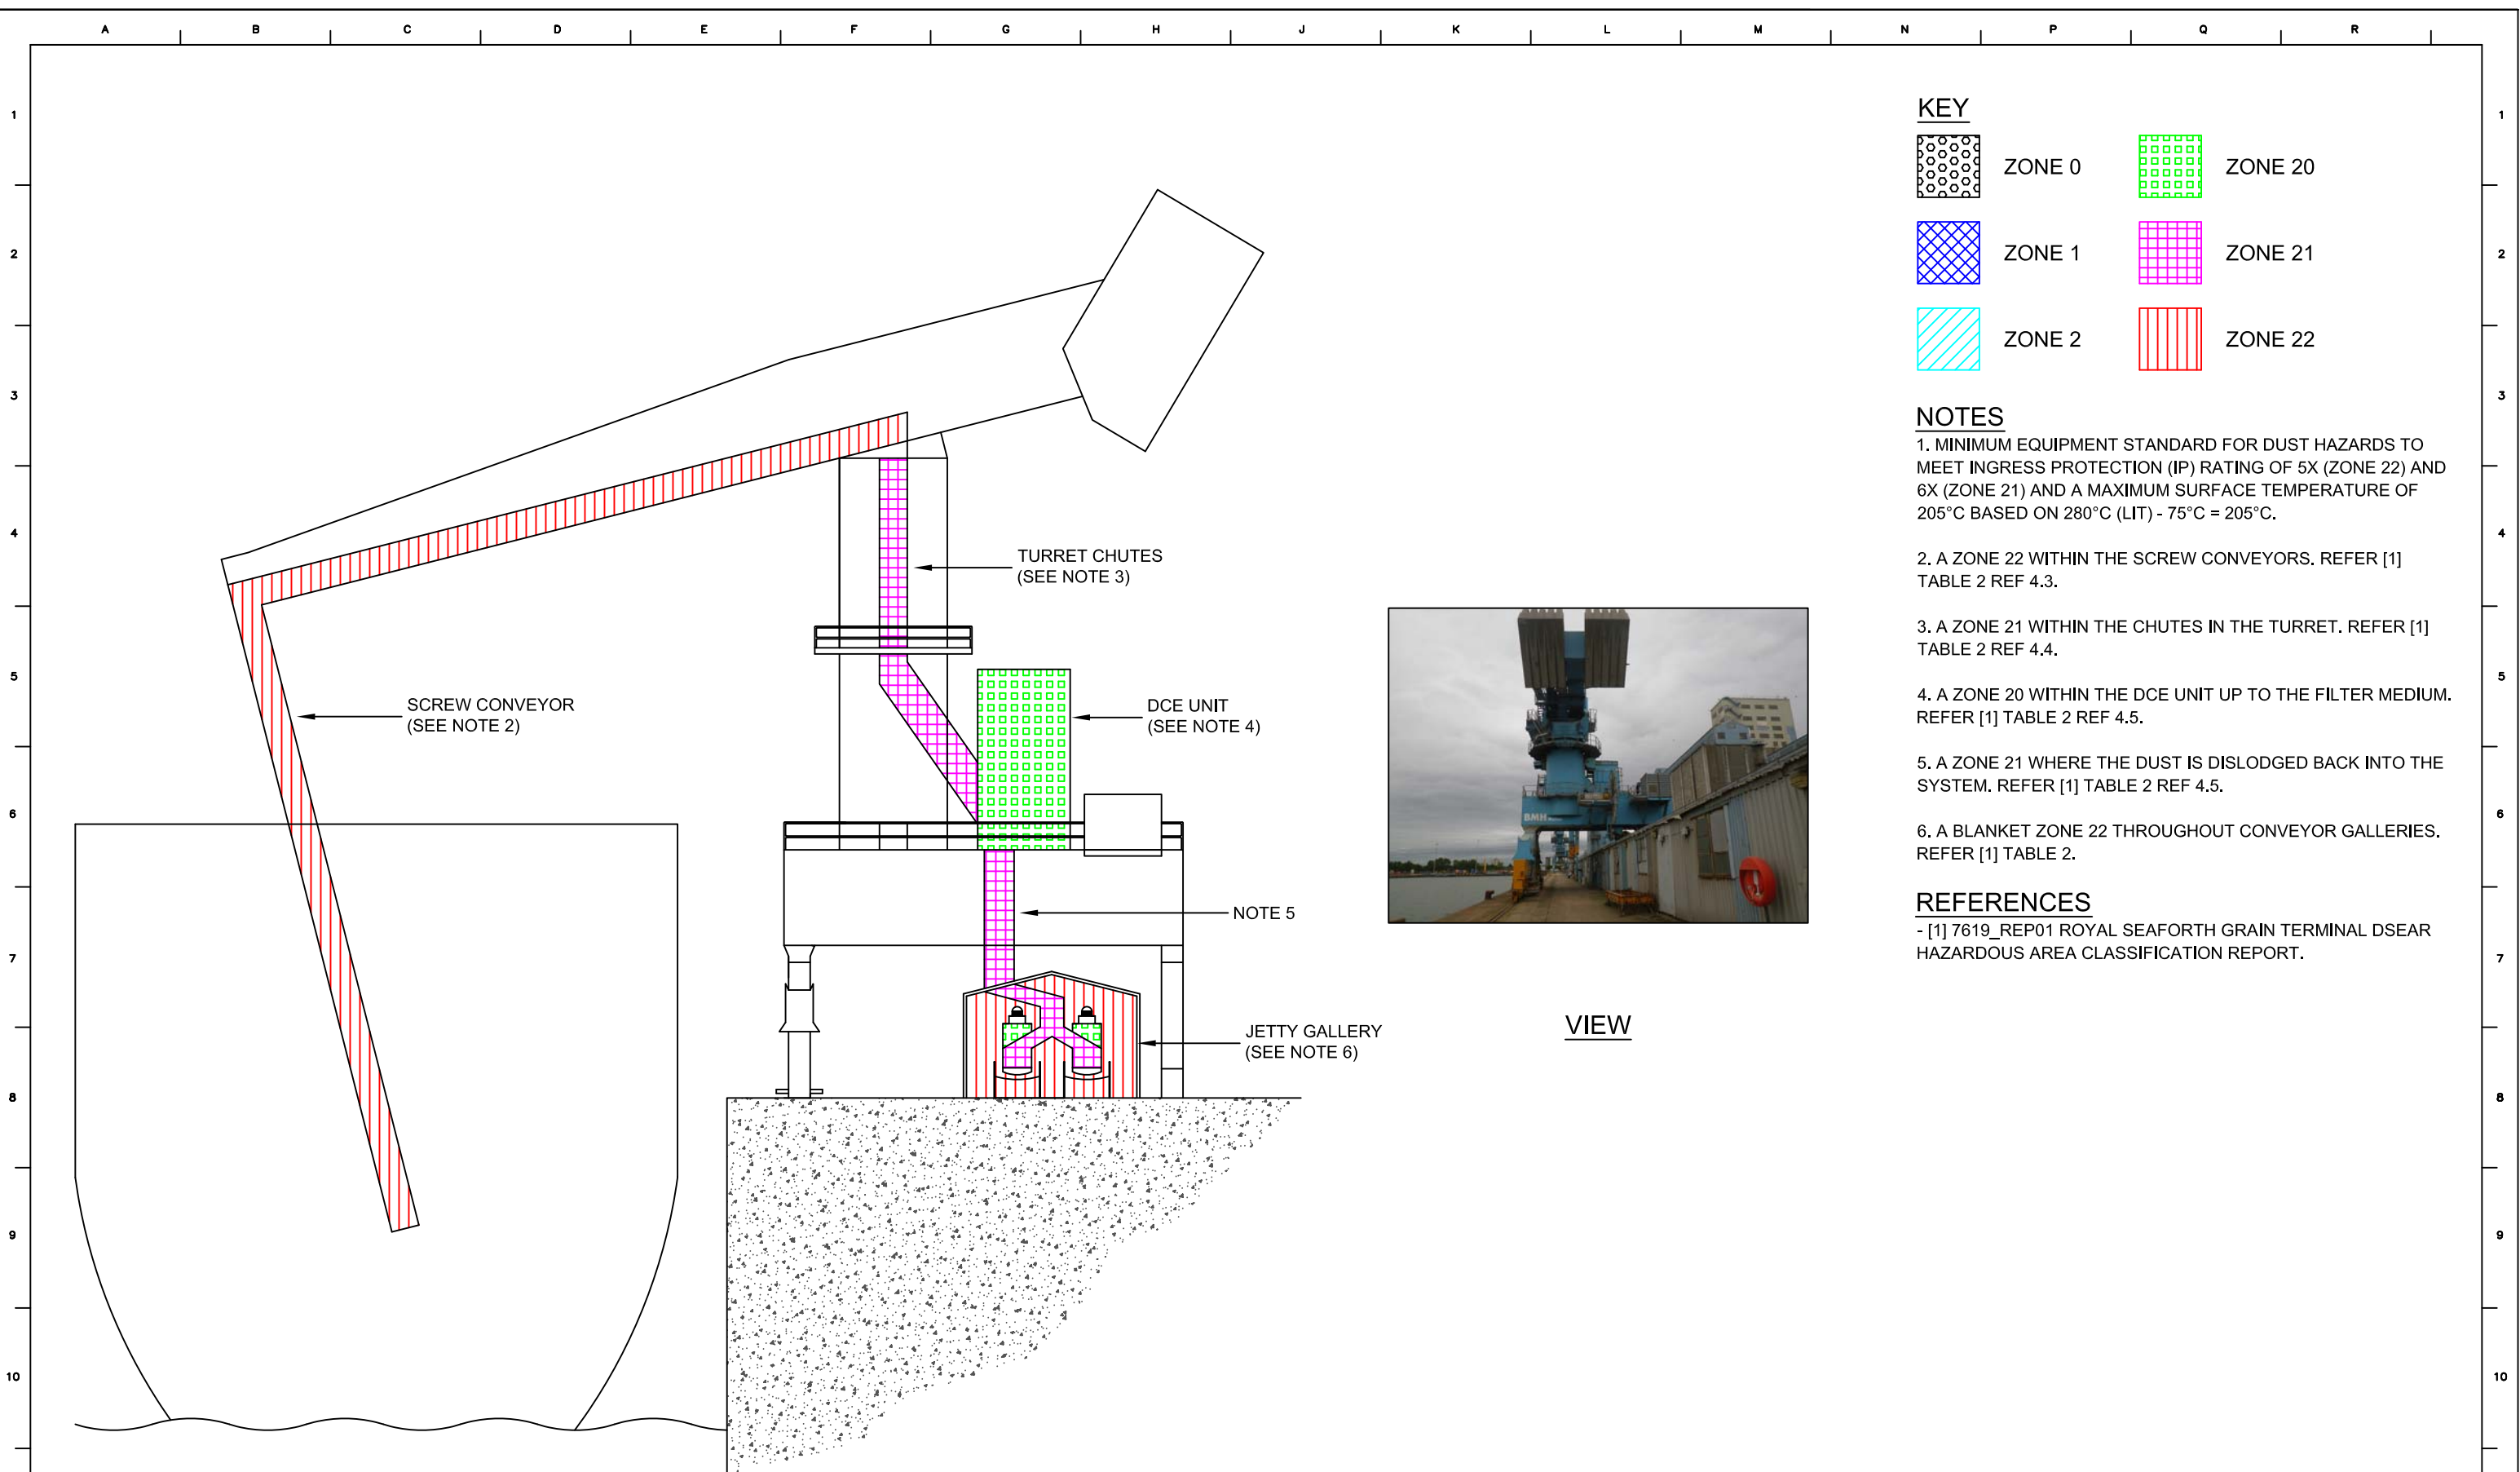 




REVISION	A
DATE	15/06/20
DESCRIPTION	AS BUILT
AUTHOR	HR
CHECKED	SDO
APPROVED	AW

 INGLEWOOD ENGINEERING CONSULTANCY LTD SYCAMORE HOUSE, SPRINGWOOD WAY, TYTHERINGTON BUSINESS PARK, MACCLESFIELD, CHESHIRE, SK10 2ND, 01625 410100 INFO@INGLEWOODENGINEERING.COM	PROJECT DSEAR AREA CLASSIFICATION			TITLE ROYAL SEAFORTH GRAIN TERMINAL SILVERTELL SHIP UNLOADER AREA CLASSIFICATION DRAWING		
	IEC PROJECT No. 7840			DRAWING No. SHT No. REV. 7840-73-00008 A		
	IEC DRAWING No. 7840-73-00008					
	SCALE	DRAWN H. RAZA	DATE 15/06/20			
NTS @ A3	CHECKED S. OWEN	DATE 29/06/20				
	APPROVED A. WOOD	DATE 09/07/20				