



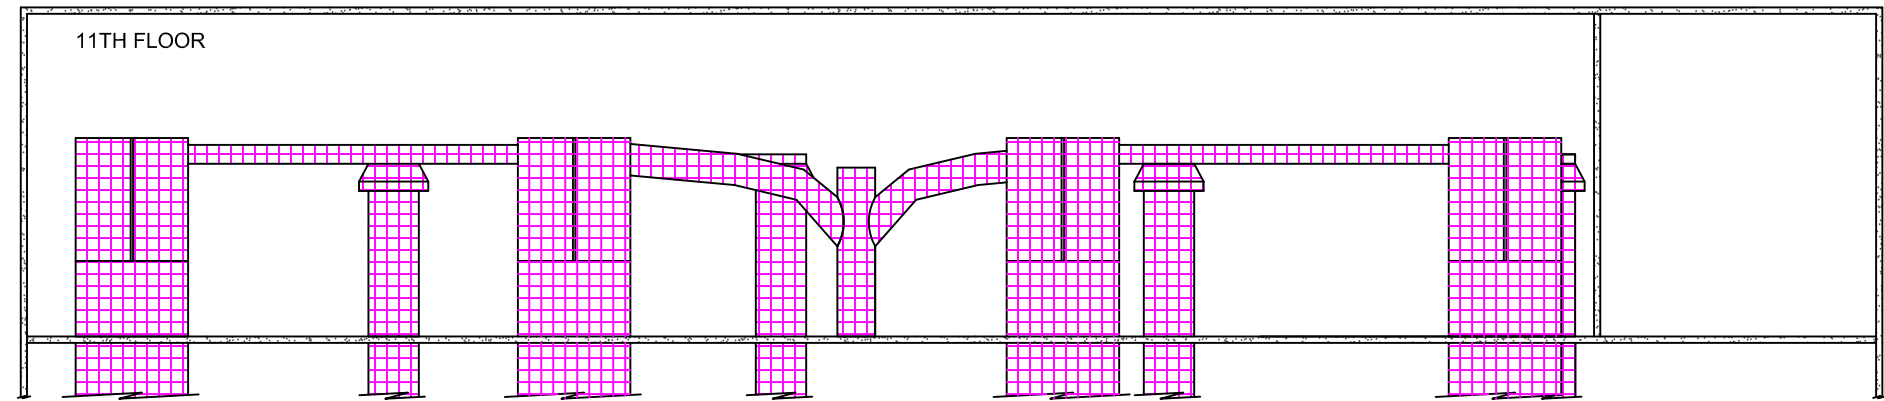

ELEVATION

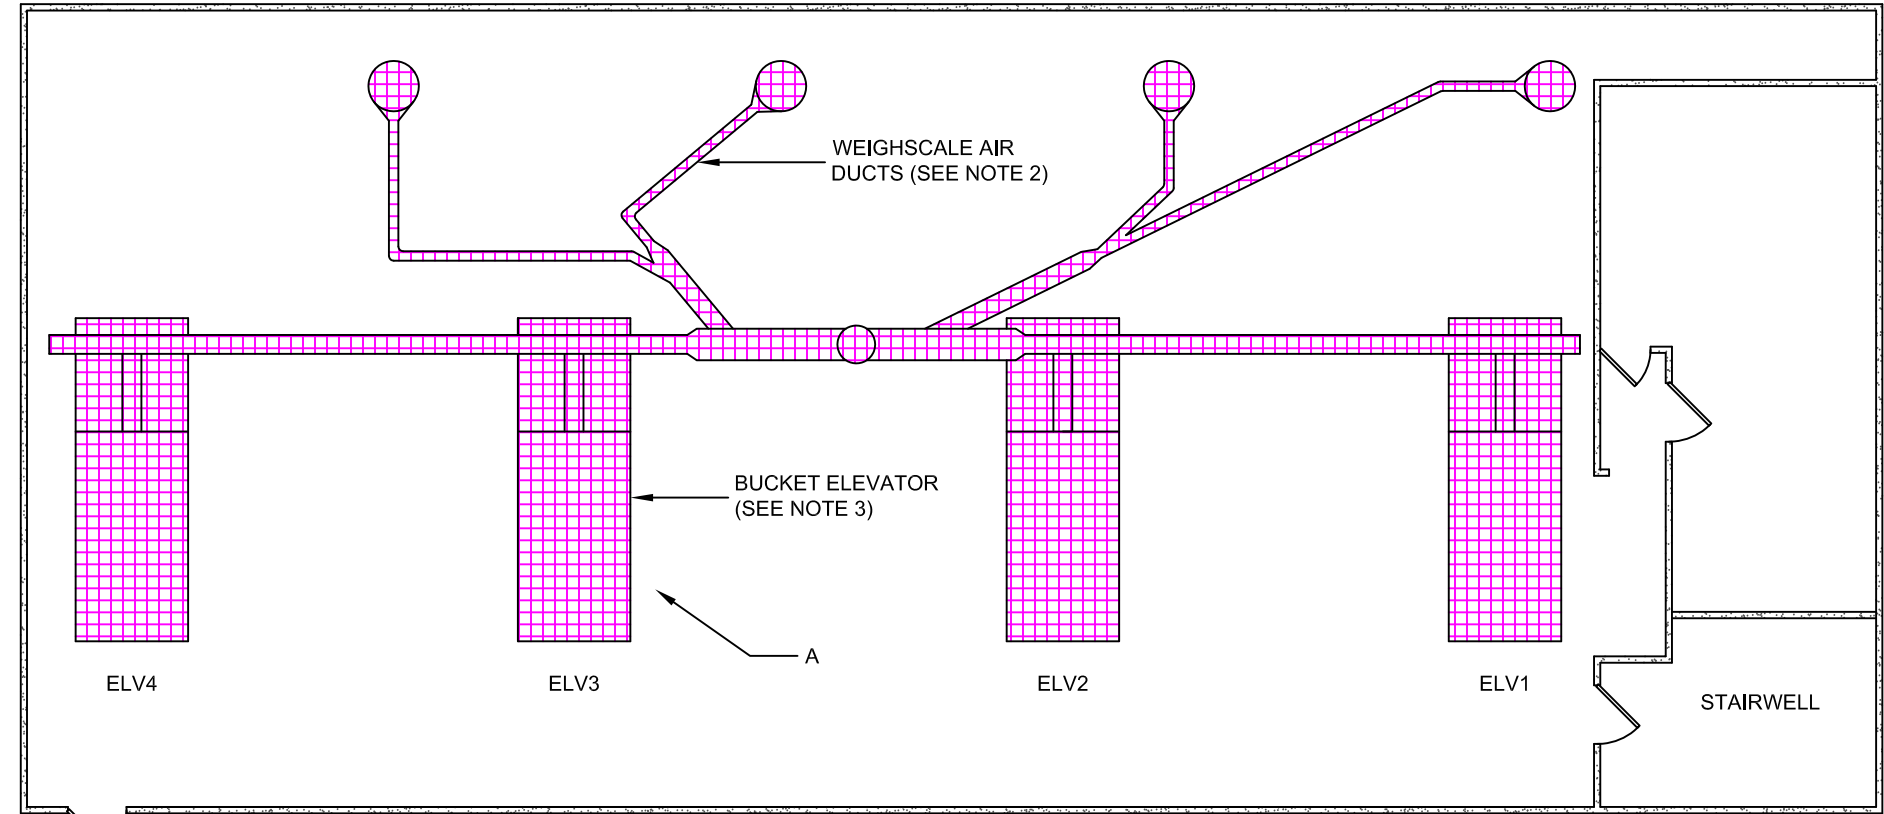

PLAN

KEY

	ZONE 0		ZONE 20
	ZONE 1		ZONE 21
	ZONE 2		ZONE 22

NOTES

1. MINIMUM EQUIPMENT STANDARD FOR DUST HAZARDS TO MEET INGRESS PROTECTION (IP) RATING OF 5X (ZONE 22) AND 6X (ZONE 21) AND A MAXIMUM SURFACE TEMPERATURE OF 205°C BASED ON 280°C (LIT) - 75°C = 205°C.
2. A ZONE 21 WITHIN THE WEIGHSCALE AIR DUCTS. REFER [1] TABLE 2 REF 4.21.
3. A ZONE 21 WITHIN THE BUCKET ELEVATOR. REFER [1] TABLE 2.

REFERENCES

- [1] 7619_REP01 ROYAL SEAFORTH GRAIN TERMINAL DSEAR HAZARDOUS AREA CLASSIFICATION REPORT.



VIEW ON A

REVISION	A
DATE	15/06/20
DESCRIPTION	AS BUILT
AUTHOR	HR
CHECKED	SDO
APPROVED	AW



INGLEWOOD ENGINEERING
CONSULTANCY LTD
SYCAMORE HOUSE,
SPRINGWOOD WAY,
TYTHERINGTON BUSINESS PARK,
MACCLESFIELD, CHESHIRE,
SK10 2ND, 01625 410100
INFO@INGLEWOODENGINEERING.COM

PROJECT DSEAR AREA CLASSIFICATION			
IEC PROJECT No. 7840			
IEC DRAWING No. 7840-73-00009			
SCALE NTS @ A3	DRAWN	H. RAZA	DATE 15/06/20
	CHECKED	S. OWEN	DATE 29/06/20
	APPROVED	A. WOOD	DATE 09/07/20

TITLE		
ROYAL SEAFORTH GRAIN TERMINAL WORKHOUSE 11TH FLOOR AREA CLASSIFICATION DRAWING		
DRAWING No.	SHT No.	REV.
7840-73-00009		A