




ZONE 0



ZONE 20

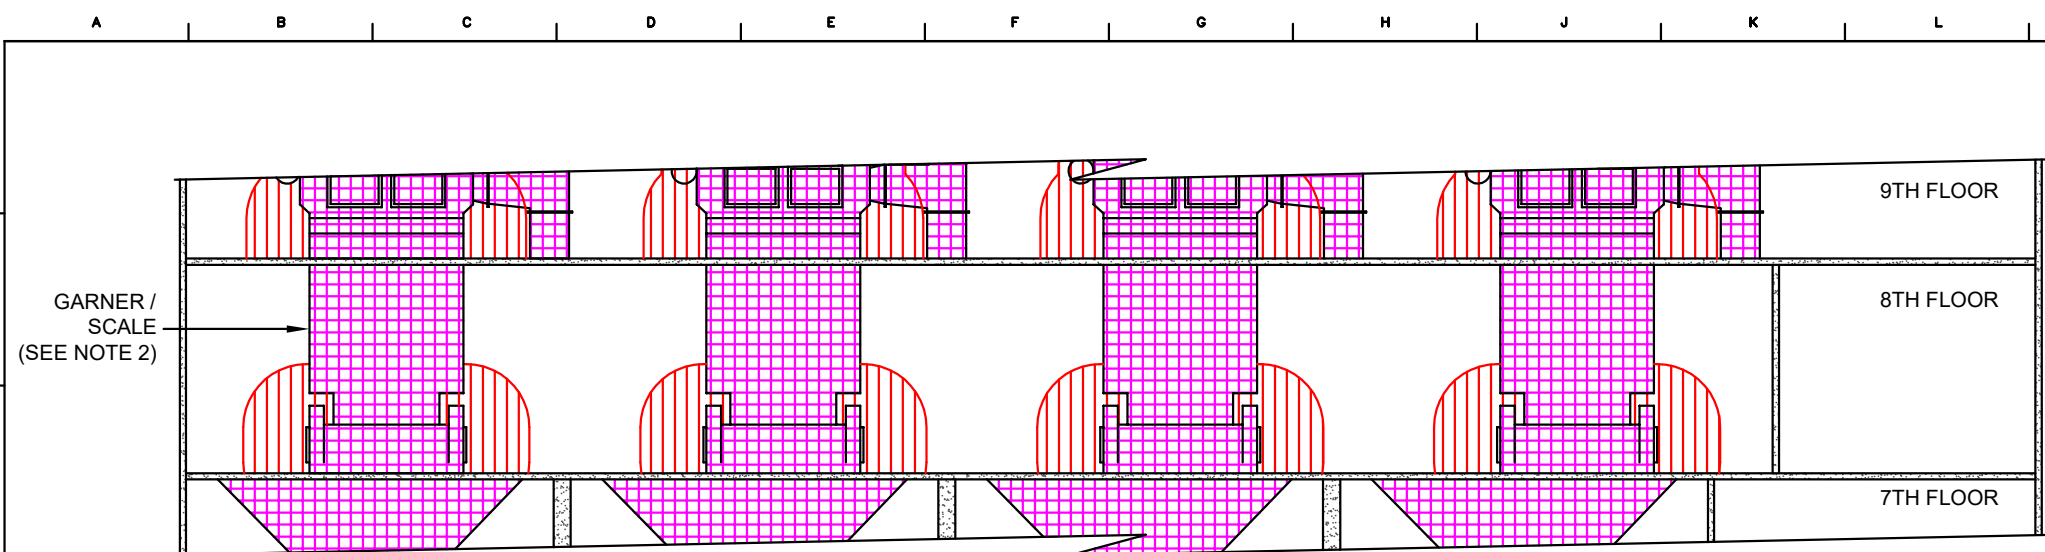

ZONE 1



ZONE 21



ZONE 2



ZONE 22

NOTES

1. MINIMUM EQUIPMENT STANDARD FOR DUST HAZARDS TO MEET INGRESS PROTECTION (IP) RATING OF 5X (ZONE 22) AND 6X (ZONE 21) AND A MAXIMUM SURFACE TEMPERATURE OF 205°C BASED ON 280°C (LIT) - 75°C = 205°C.


2. A BLANKET ZONE 21 WITHIN THE GARNER AND WEIGHSCALES. REFER [1] TABLE 2 REF 4.30.

3. A ZONE 22 OF A 1m RADIUS AROUND THE HATCHES. REFER [1] TABLE 2 REF 4.32.

4. A ZONE 21 WITHIN THE BUCKET ELEVATOR. REFER [1] TABLE 2.

REFERENCES

- [1] 7619_REP01 ROYAL SEAFORTH GRAIN TERMINAL DSEAR
HAZARDOUS AREA CLASSIFICATION REPORT.

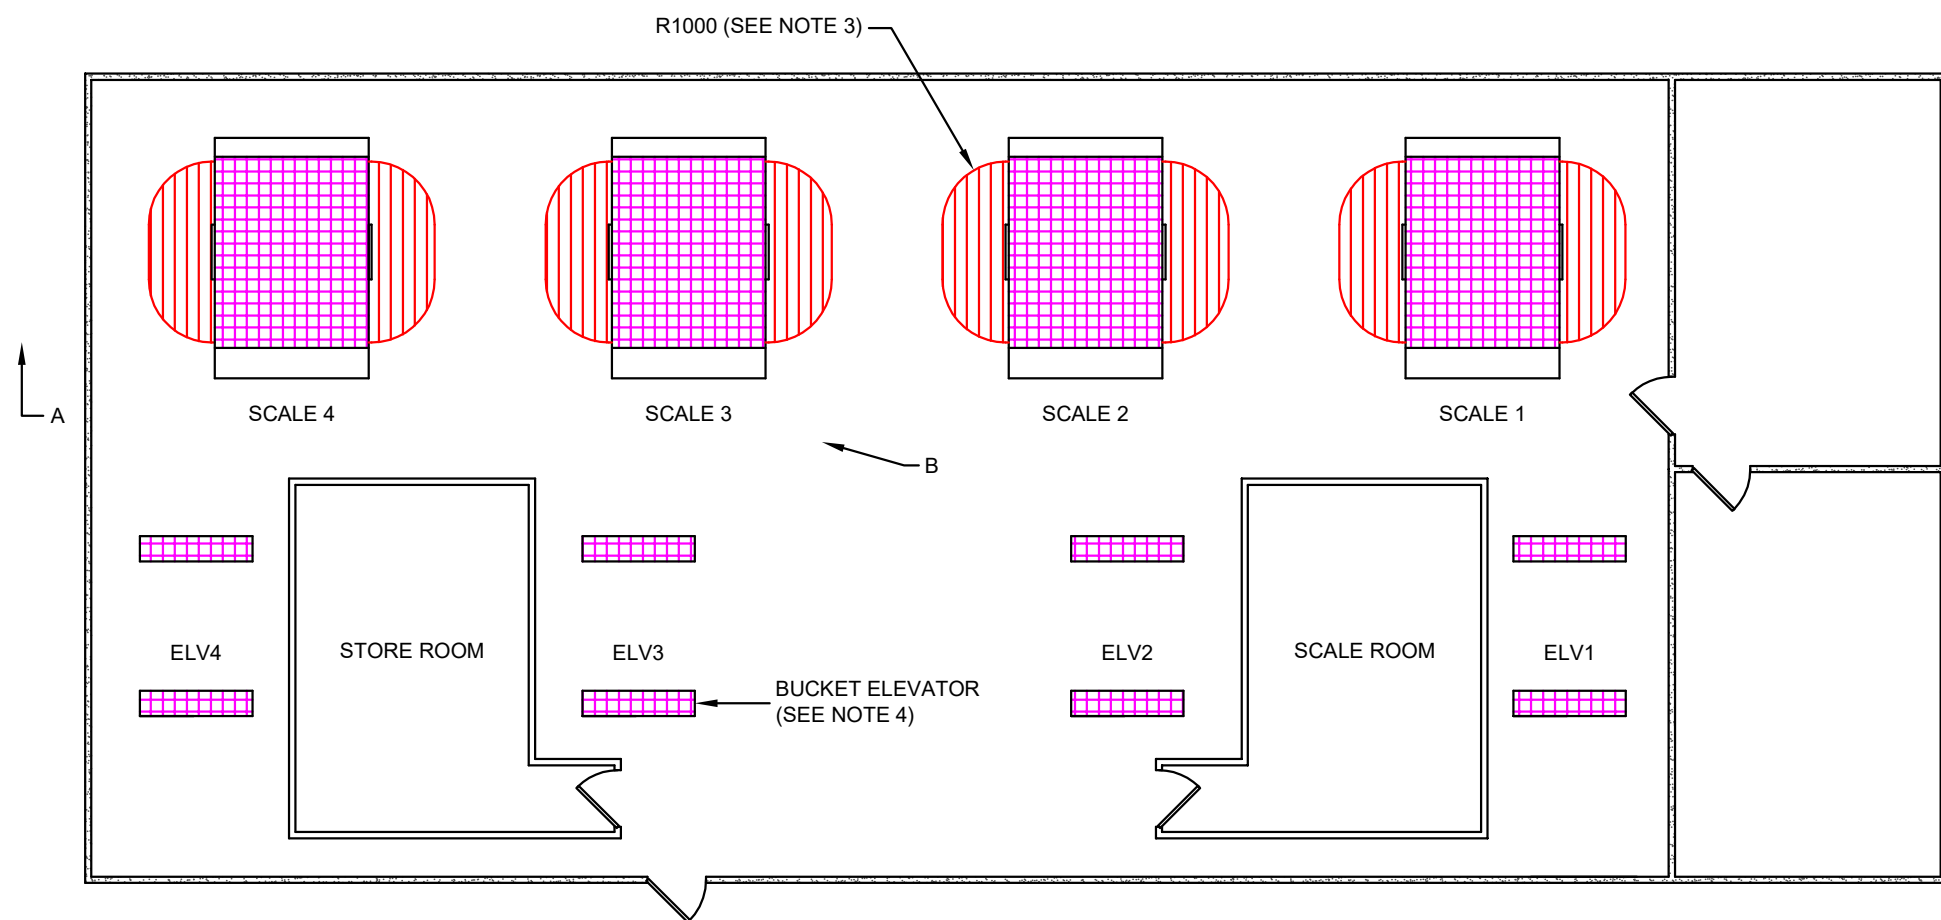

REVISION	A
DATE	15/06/20
DESCRIPTION	AS BUILT
AUTHOR	HR
CHECKED	SDO
APPROVED	AW



**INGLEWOOD ENGINEERING
CONSULTANCY LTD**
SYCAMORE HOUSE,
SPRINGWOOD WAY,
TYTHERINGTON BUSINESS PARK,
MACCLESFIELD, CHESHIRE,
SK10 2ND, 01625 410100
INFO@INGLEWOODENGINEERING.COM

PROJECT		
DSEAR AREA CLASSIFICATION		
IEC PROJECT No. 7840		
IEC DRAWING No. 7840-73-00012		
SCALE	DRAWN H. RAZA	DATE 15/06/20
NTS @ A3	CHECKED S. OWEN	DATE 29/06/20
	APPROVED A. WOOD	DATE 09/07/20

TITLE		
ROYAL SEAFORTH GRAIN TERMINAL WORKHOUSE 8TH FLOOR AREA CLASSIFICATION DRAWING		
DRAWING No.	SHT No.	REV.
7840-73-00012		A