


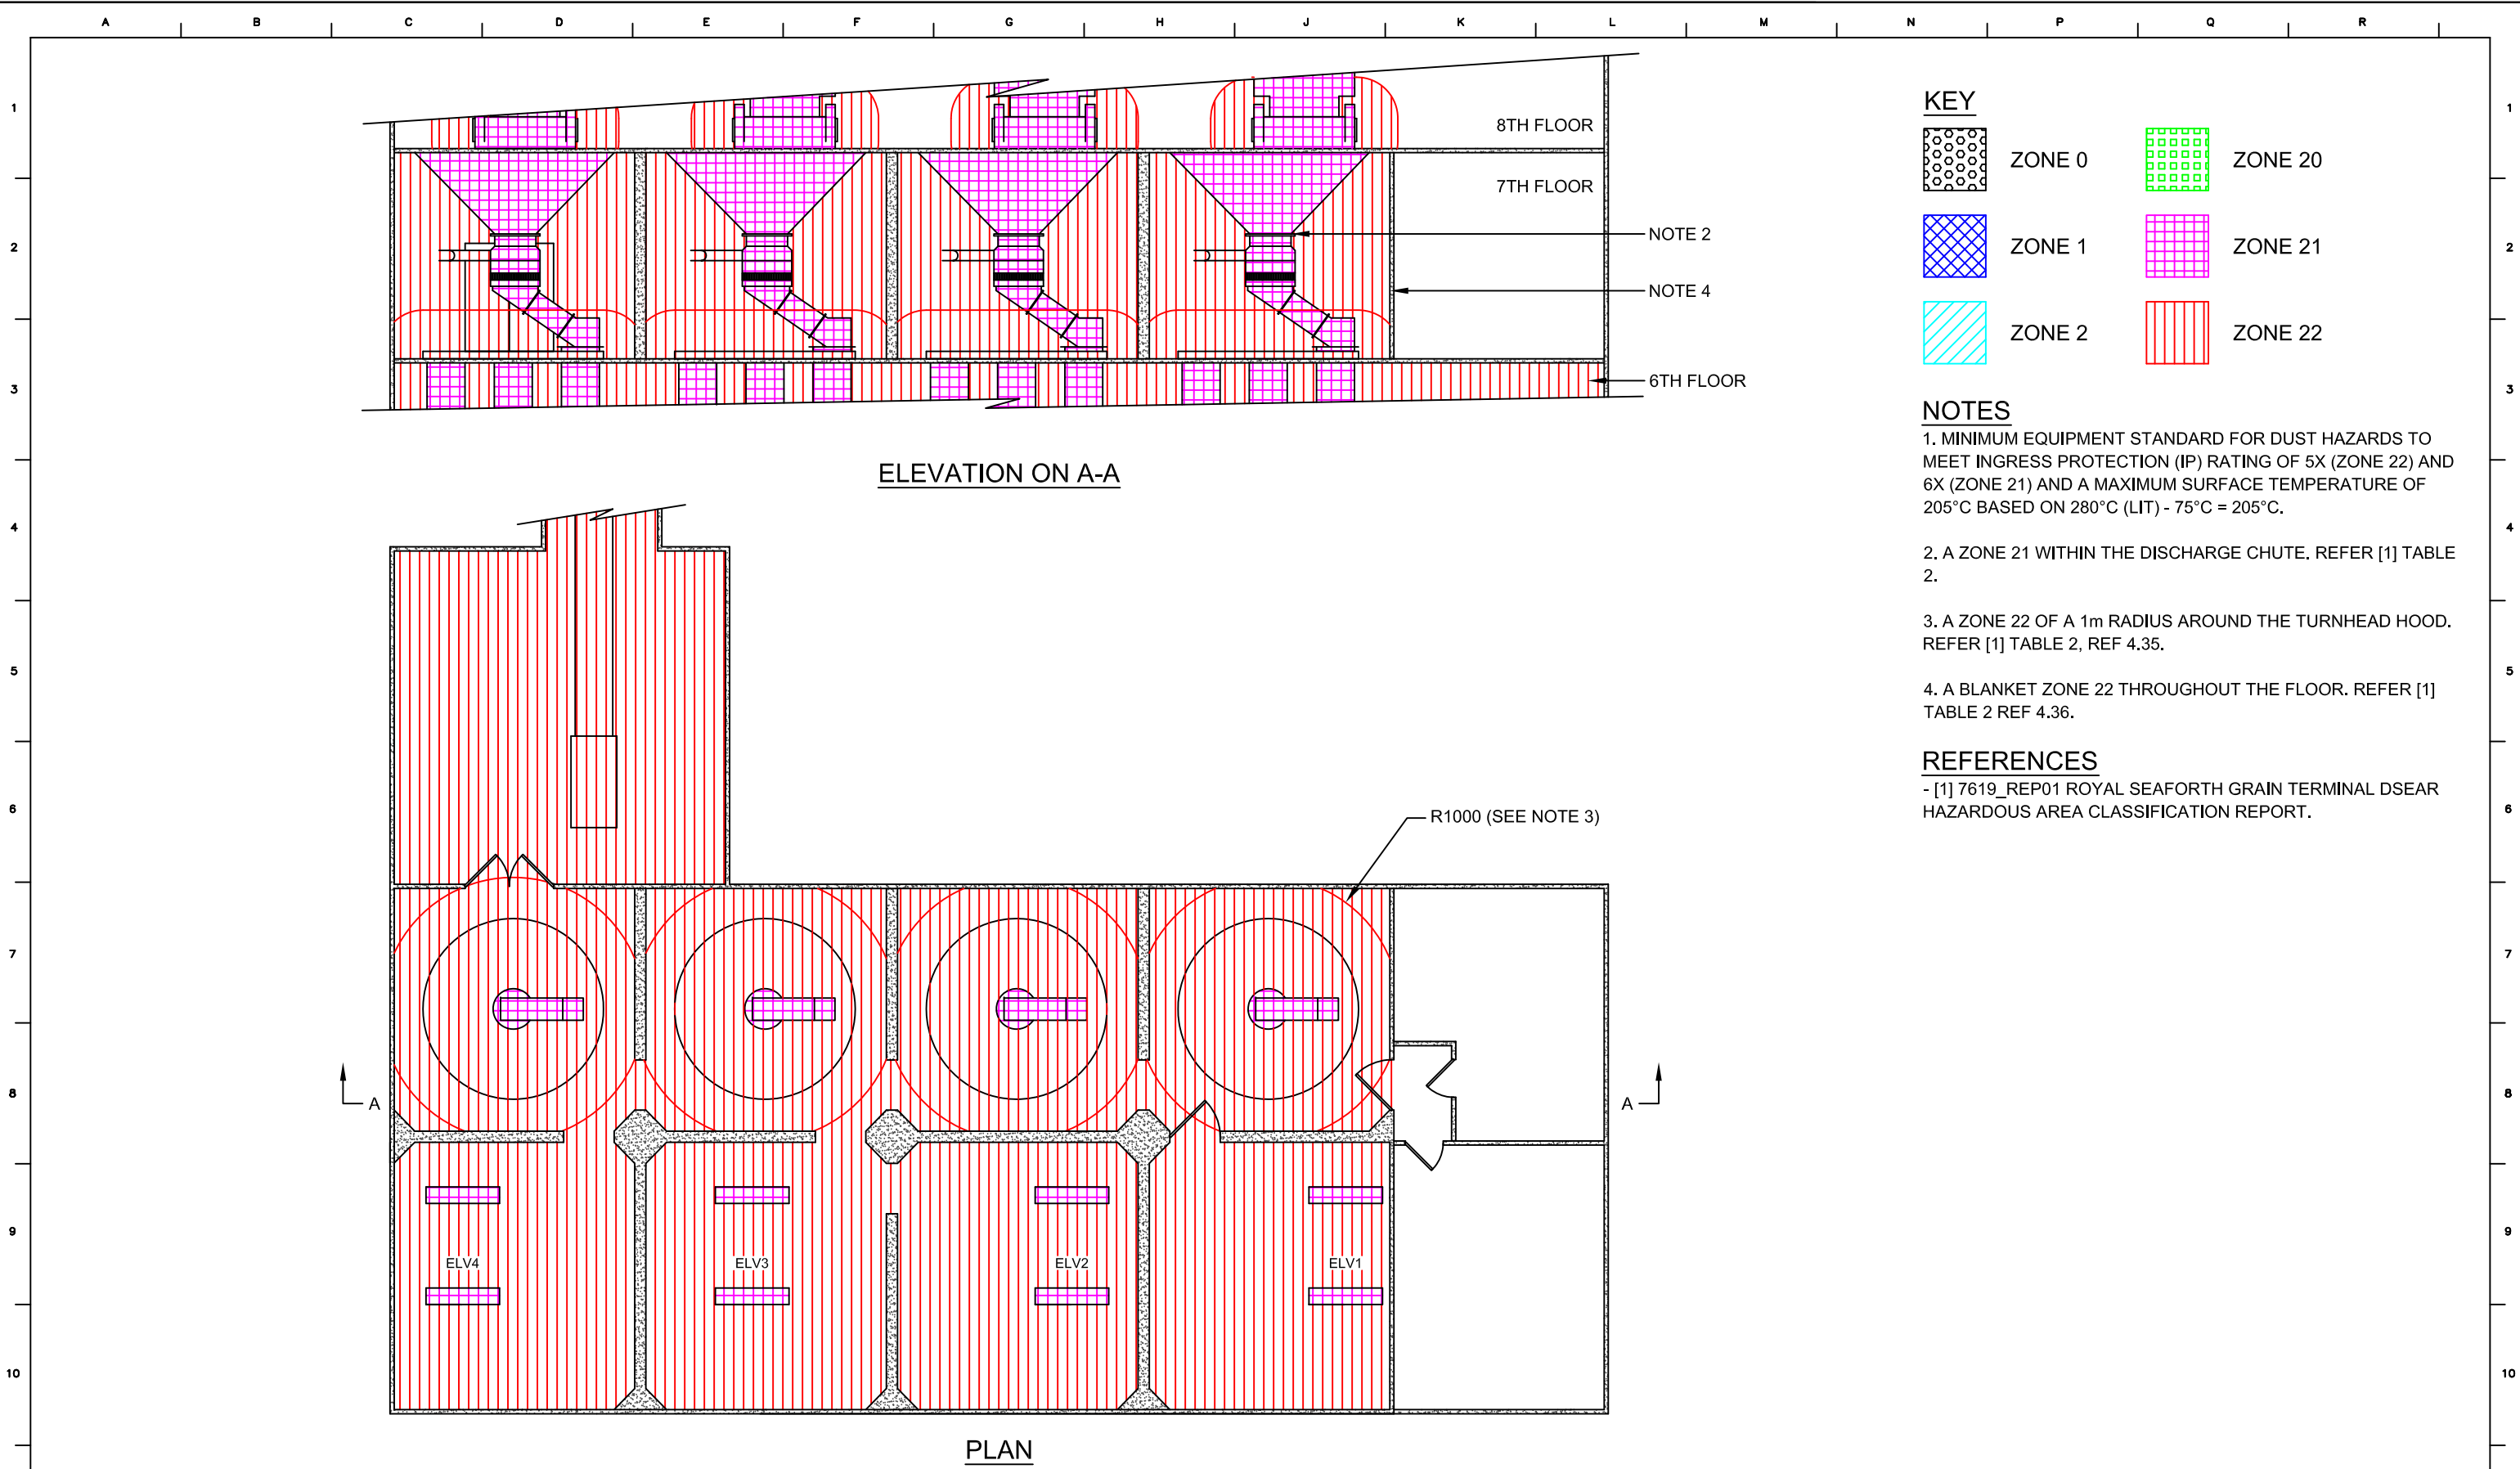

11	REVISION		A	 INGLEWOOD ENGINEERING CONSULTANCY LTD SYCAMORE HOUSE, SPRINGWOOD WAY, TYTHERINGTON BUSINESS PARK, MACCLESFIELD, CHESHIRE, SK10 2ND, 01625 410100 INFO@INGLEWOODENGINEERING.COM	PROJECT				TITLE ROYAL SEAFORTH GRAIN TERMINAL WORKHOUSE 7TH FLOOR AREA CLASSIFICATION DRAWING				
	DATE		15/06/20		DSEAR AREA CLASSIFICATION								
	DESCRIPTION		AS BUILT		IEC PROJECT No. 7840								
			IEC DRAWING No. 7840-73-00013										
AUTHOR		HR	SCALE		DRAWN	H. RAZA	DATE	15/06/20	DRAWING No.		SHT No.	REV. A	
CHECKED		SDO	NTS @ A3		CHECKED	S. OWEN	DATE	29/06/20	7840-73-00013				
APPROVED		AW			APPROVED	A. WOOD	DATE	09/07/20					