


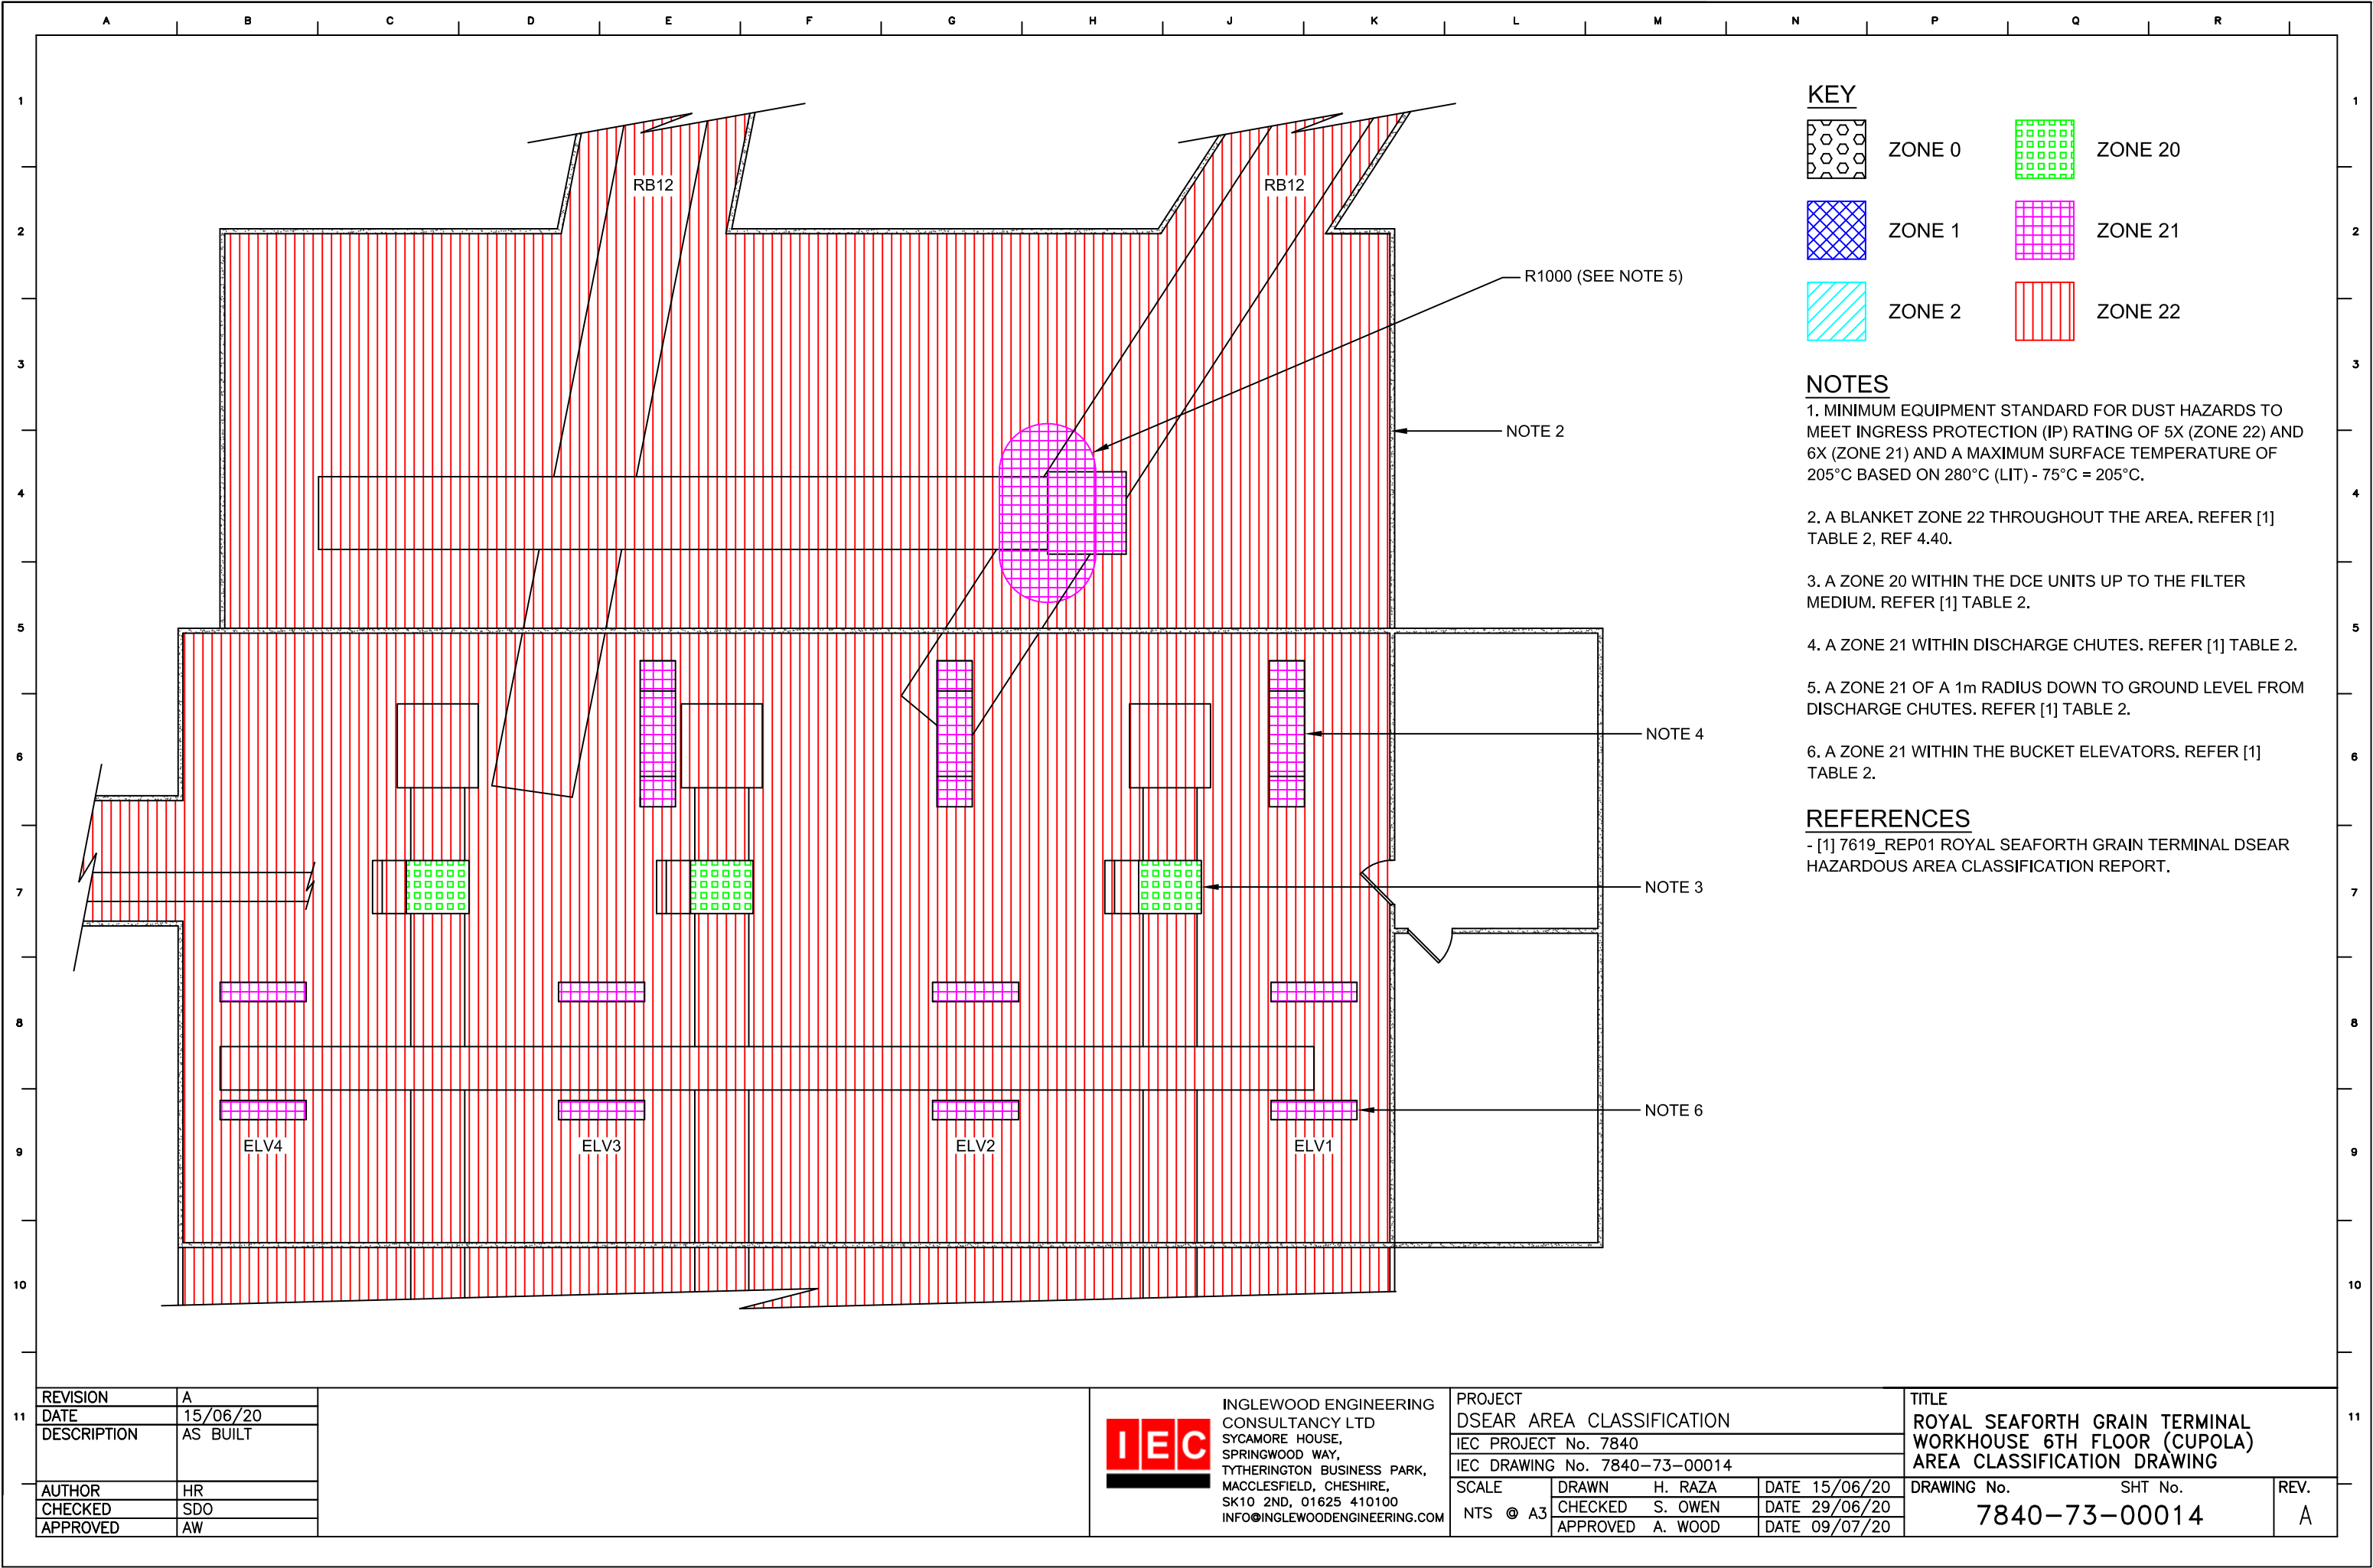

KEY

-  ZONE 0
-  ZONE 20
-  ZONE 1
-  ZONE 21
-  ZONE 2
-  ZONE 22

NOTES

1. MINIMUM EQUIPMENT STANDARD FOR DUST HAZARDS TO MEET INGRESS PROTECTION (IP) RATING OF 5X (ZONE 22) AND 6X (ZONE 21) AND A MAXIMUM SURFACE TEMPERATURE OF 205°C BASED ON 280°C (LIT) - 75°C = 205°C.
2. A BLANKET ZONE 22 THROUGHOUT THE AREA. REFER [1] TABLE 2, REF 4.40.
3. A ZONE 20 WITHIN THE DCE UNITS UP TO THE FILTER MEDIUM. REFER [1] TABLE 2.
4. A ZONE 21 WITHIN DISCHARGE CHUTES. REFER [1] TABLE 2.
5. A ZONE 21 OF A 1m RADIUS DOWN TO GROUND LEVEL FROM DISCHARGE CHUTES. REFER [1] TABLE 2.
6. A ZONE 21 WITHIN THE BUCKET ELEVATORS. REFER [1] TABLE 2.

REFERENCES

- [1] 7619_REP01 ROYAL SEAFORTH GRAIN TERMINAL DSEAR HAZARDOUS AREA CLASSIFICATION REPORT.

REVISION	A
DATE	15/06/20
DESCRIPTION	AS BUILT
AUTHOR	HR
CHECKED	SDO
APPROVED	AW



INGLEWOOD ENGINEERING
CONSULTANCY LTD
SYCAMORE HOUSE,
SPRINGWOOD WAY,
TYTHERINGTON BUSINESS PARK,
MACCLESFIELD, CHESHIRE,
SK10 2ND, 01625 410100
INFO@INGLEWOODENGINEERING.COM

PROJECT DSEAR AREA CLASSIFICATION			
IEC PROJECT No. 7840			
IEC DRAWING No. 7840-73-00014			
SCALE	DRAWN	H. RAZA	DATE 15/06/20
NTS @ A3	CHECKED	S. OWEN	DATE 29/06/20
	APPROVED	A. WOOD	DATE 09/07/20

TITLE ROYAL SEAFORTH GRAIN TERMINAL WORKHOUSE 6TH FLOOR (CUPOLA) AREA CLASSIFICATION DRAWING		
DRAWING No.	SHT No.	REV.
7840-73-00014		A