




KEY



ZONE 0

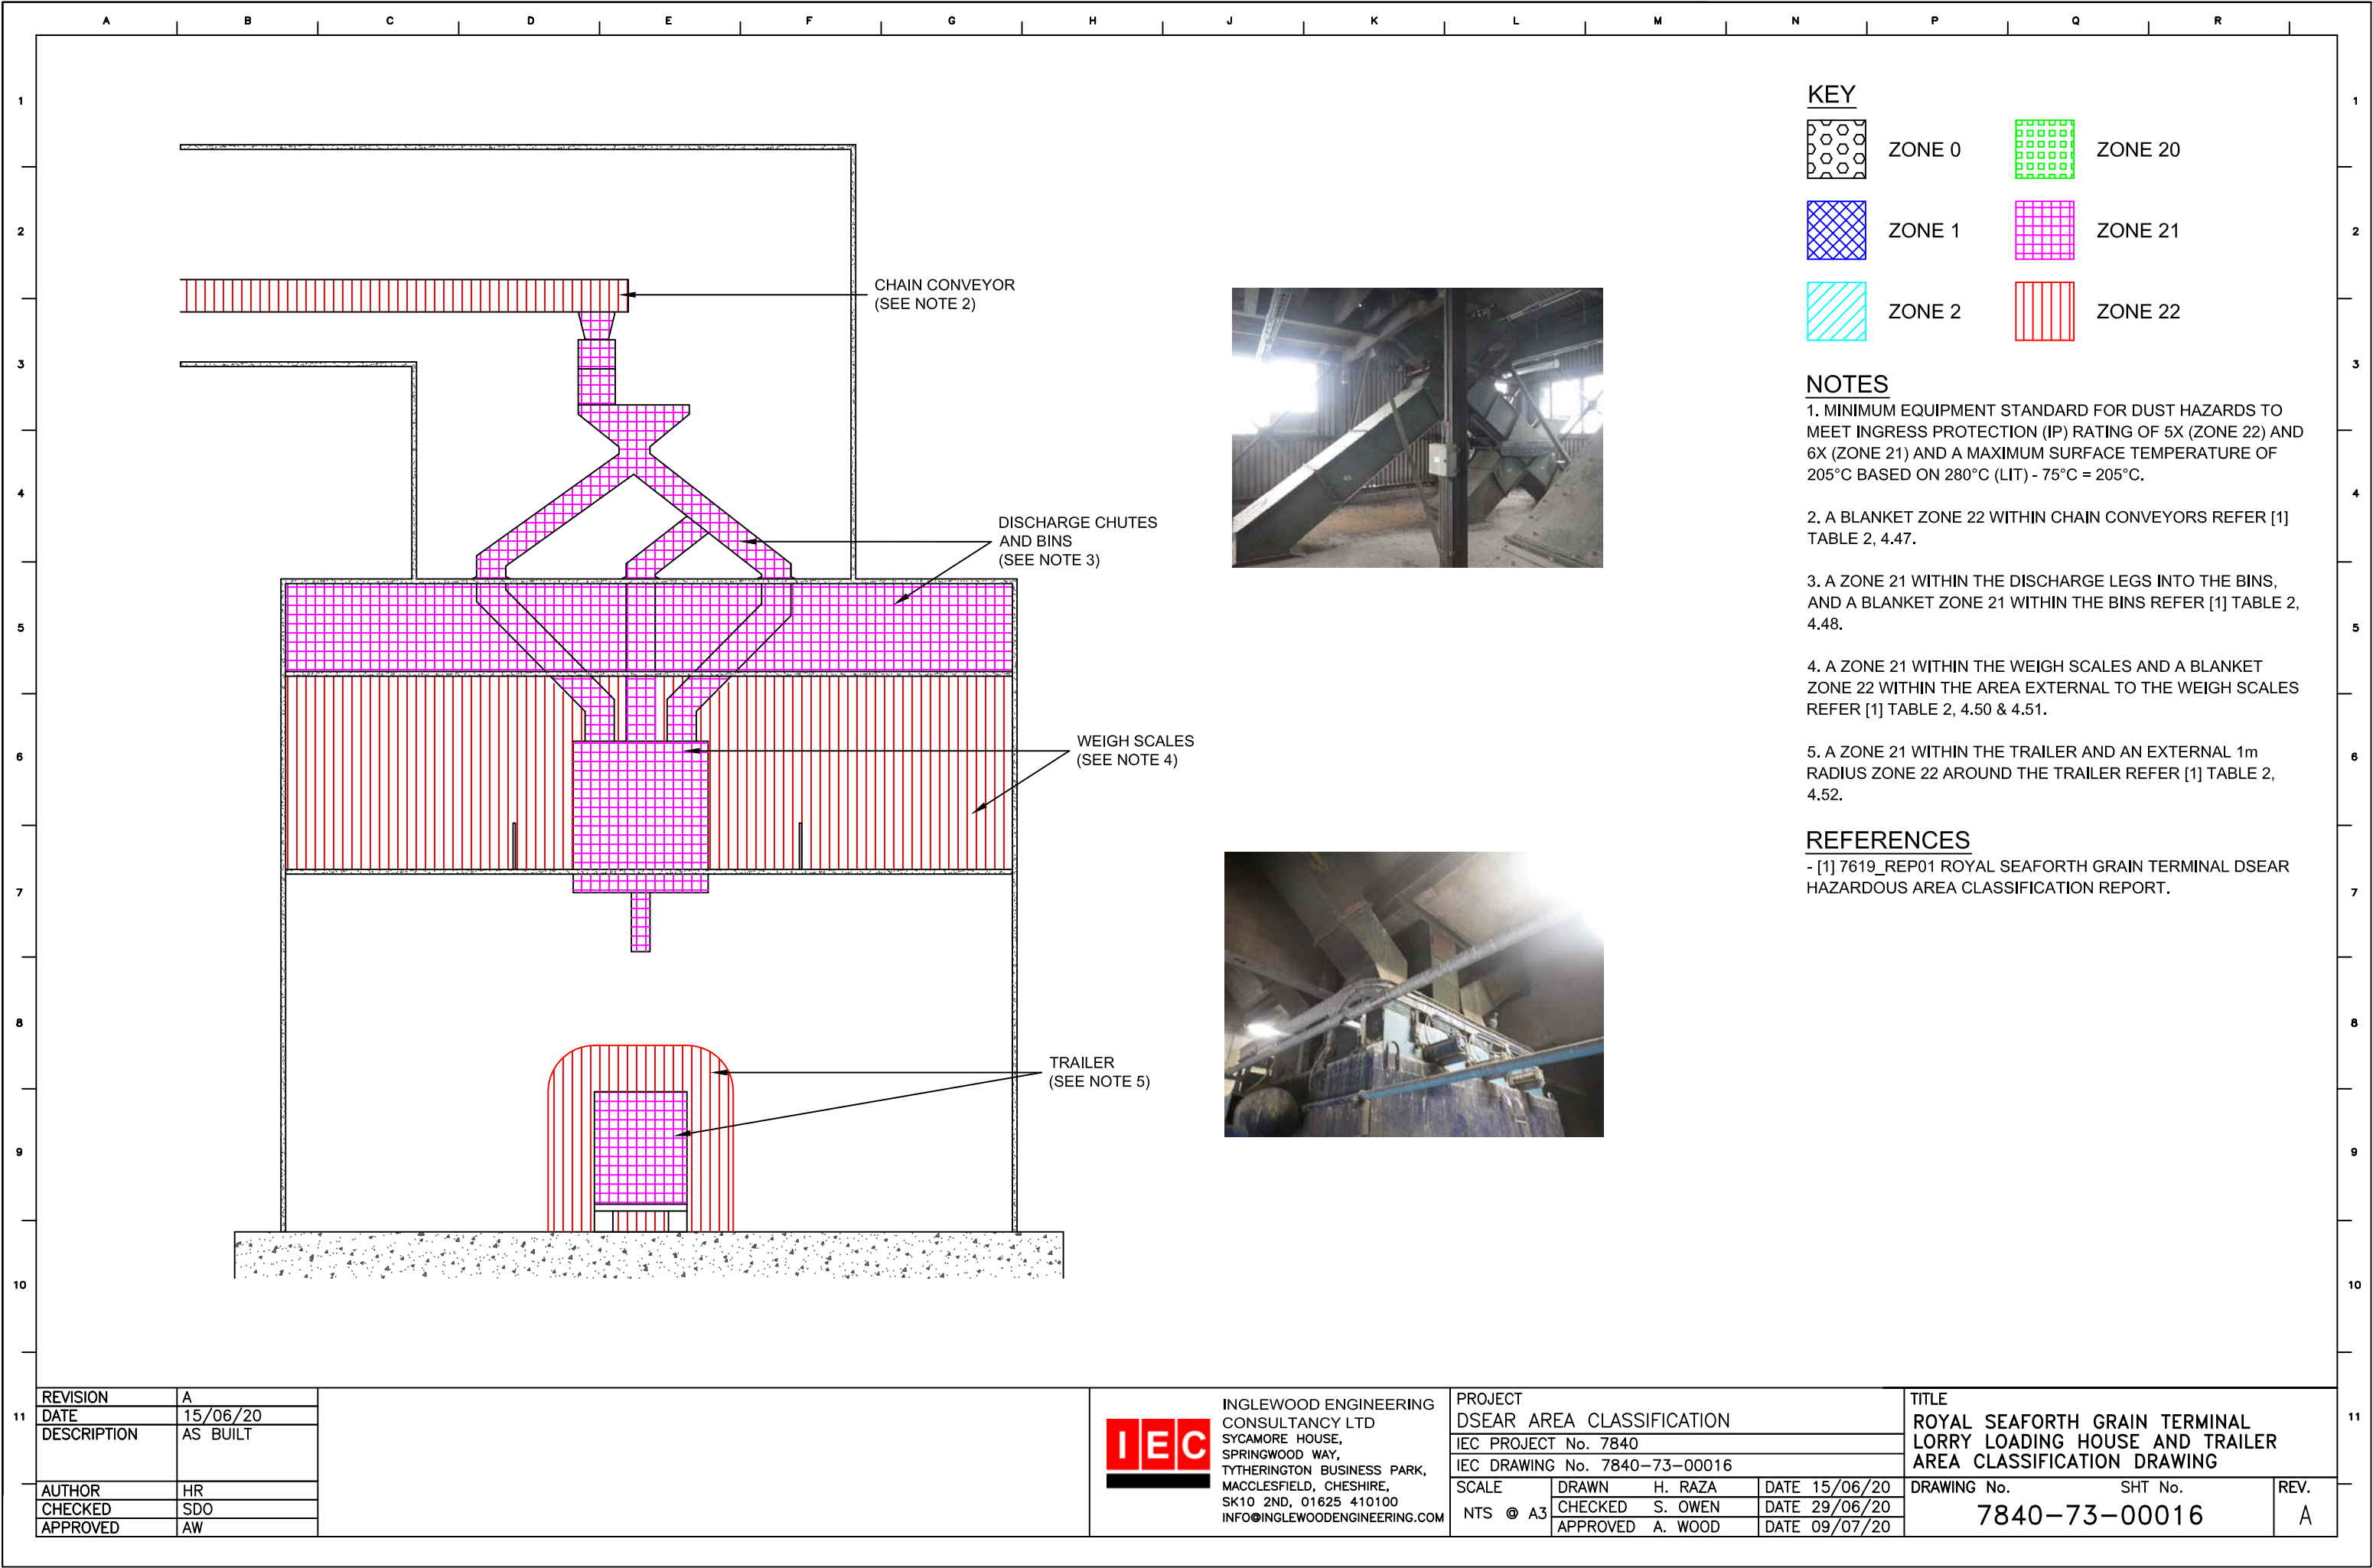

ZONE 20



ZONE 1



ZONE 21



ZONE 2



ZONE 22

NOTES

1. MINIMUM EQUIPMENT STANDARD FOR DUST HAZARDS TO MEET INGRESS PROTECTION (IP) RATING OF 5X (ZONE 22) AND 6X (ZONE 21) AND A MAXIMUM SURFACE TEMPERATURE OF 205°C BASED ON 280°C (LIT) - 75°C = 205°C.
2. A BLANKET ZONE 22 WITHIN CHAIN CONVEYORS REFER [1] TABLE 2, 4.47.
3. A ZONE 21 WITHIN THE DISCHARGE LEGS INTO THE BINS, AND A BLANKET ZONE 21 WITHIN THE BINS REFER [1] TABLE 2, 4.48.
4. A ZONE 21 WITHIN THE WEIGH SCALES AND A BLANKET ZONE 22 WITHIN THE AREA EXTERNAL TO THE WEIGH SCALES REFER [1] TABLE 2, 4.50 & 4.51.
5. A ZONE 21 WITHIN THE TRAILER AND AN EXTERNAL 1m RADIUS ZONE 22 AROUND THE TRAILER REFER [1] TABLE 2, 4.52.

REFERENCES

- [1] 7619_REP01 ROYAL SEAFORTH GRAIN TERMINAL DSEAR HAZARDOUS AREA CLASSIFICATION REPORT.

REVISION	A
DATE	15/06/20
DESCRIPTION	AS BUILT
AUTHOR	HR
CHECKED	SDO
APPROVED	AW



INGLEWOOD ENGINEERING
CONSULTANCY LTD
SYCAMORE HOUSE,
SPRINGWOOD WAY,
TYTHERINGTON BUSINESS PARK,
MACCLESFIELD, CHESHIRE,
SK10 2ND, 01625 410100
INFO@INGLEWOODENGINEERING.COM

PROJECT DSEAR AREA CLASSIFICATION			
IEC PROJECT No. 7840			
IEC DRAWING No. 7840-73-00016			
SCALE NTS @ A3	DRAWN	H. RAZA	DATE 15/06/20
	CHECKED	S. OWEN	DATE 29/06/20
	APPROVED	A. WOOD	DATE 09/07/20

TITLE ROYAL SEAFORTH GRAIN TERMINAL LORRY LOADING HOUSE AND TRAILER AREA CLASSIFICATION DRAWING		
DRAWING No.	SHT No.	REV.
7840-73-00016		A