




KEY



ZONE 0

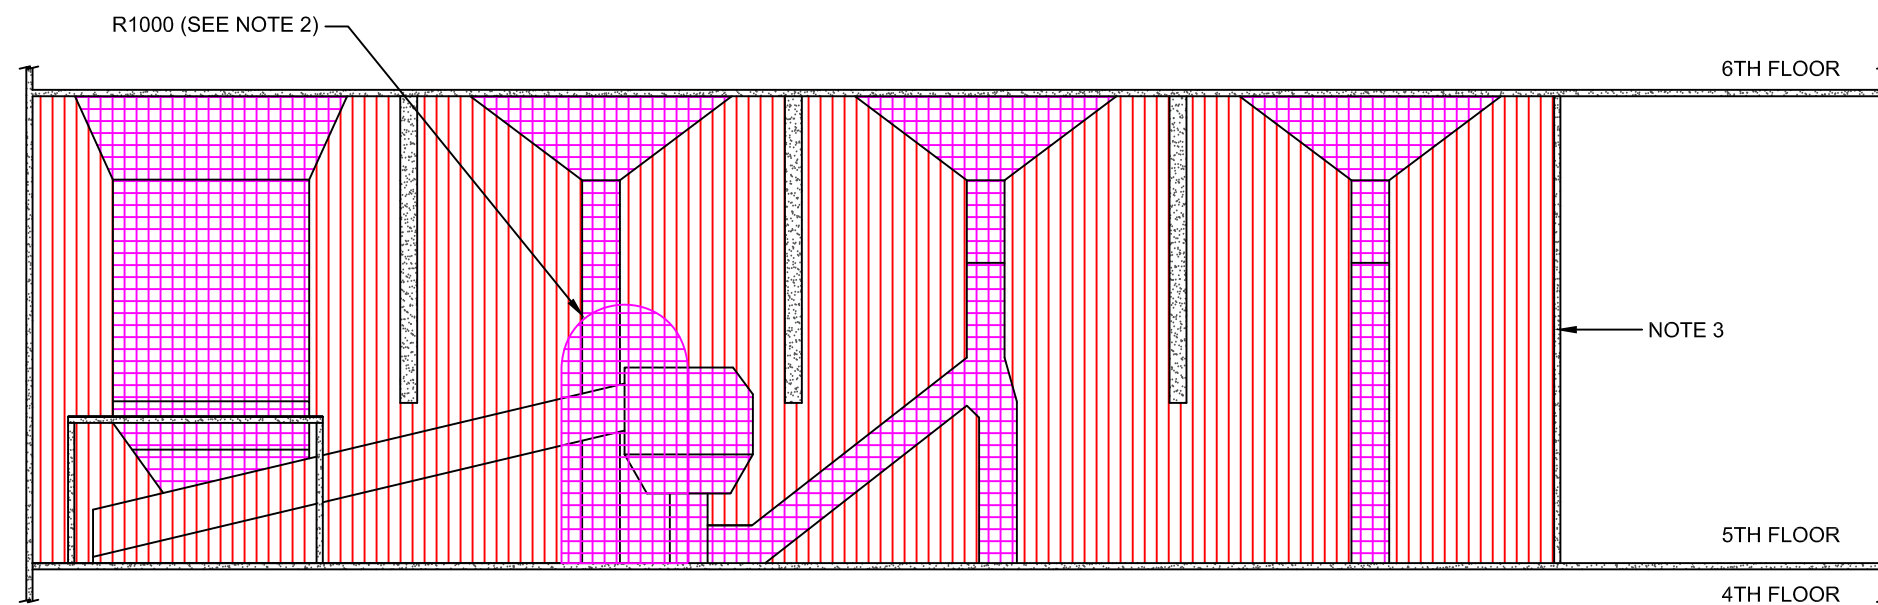

ZONE 1



ZONE 2



ZONE 20



ZONE 21



ZONE 22

NOTES

1. MINIMUM EQUIPMENT STANDARD FOR DUST HAZARDS TO MEET INGRESS PROTECTION (IP) RATING OF 5X (ZONE 22) AND 6X (ZONE 21) AND A MAXIMUM SURFACE TEMPERATURE OF 205°C BASED ON 280°C (LIT) - 75°C = 205°C.

2. A ZONE 21 WITHIN THE DISCHARGE CHUTE & 1m RADIUS DOWN TO GROUND FROM DISCHARGE POINTS. REFER [1] TABLE 2, REF 4.53.

3. A BLANKET ZONE THROUGHOUT THE FLOOR. REFER [1] TABLE 2, REF 4.53.

REFERENCES

- [1] 7619_REP01 ROYAL SEAFORTH GRAIN TERMINAL DSEAR HAZARDOUS AREA CLASSIFICATION REPORT.

REVISION	A
DATE	15/06/20
DESCRIPTION	AS BUILT
AUTHOR	SDO
CHECKED	SDO
APPROVED	AW



**INGLEWOOD ENGINEERING
CONSULTANCY LTD**
SYCAMORE HOUSE,
SPRINGWOOD WAY,
TYTHERINGTON BUSINESS PARK,
MACCLESFIELD, CHESHIRE,
SK10 2ND, 01625 410100
INFO@INGLEWOODENGINEERING.COM

PROJECT
DSEAR AREA CLASSIFICATION

IEC PROJECT No. 7840

IEC DRAWING No. 7840-73-00017

SCALE

DRAWN	S. OWEN
-------	---------

3	CHECKED	S. OWEN
---	---------	---------

3	APPROVED	A. WOOD
---	----------	---------

TITLE	ROYAL SEAFORTH GRAIN TERMINAL WORKHOUSE 5TH FLOOR AREA CLASSIFICATION DRAWING
-------	---

	DRAWING No.	SHT No.
--	-------------	---------

7840-73-00017

EV.

A