


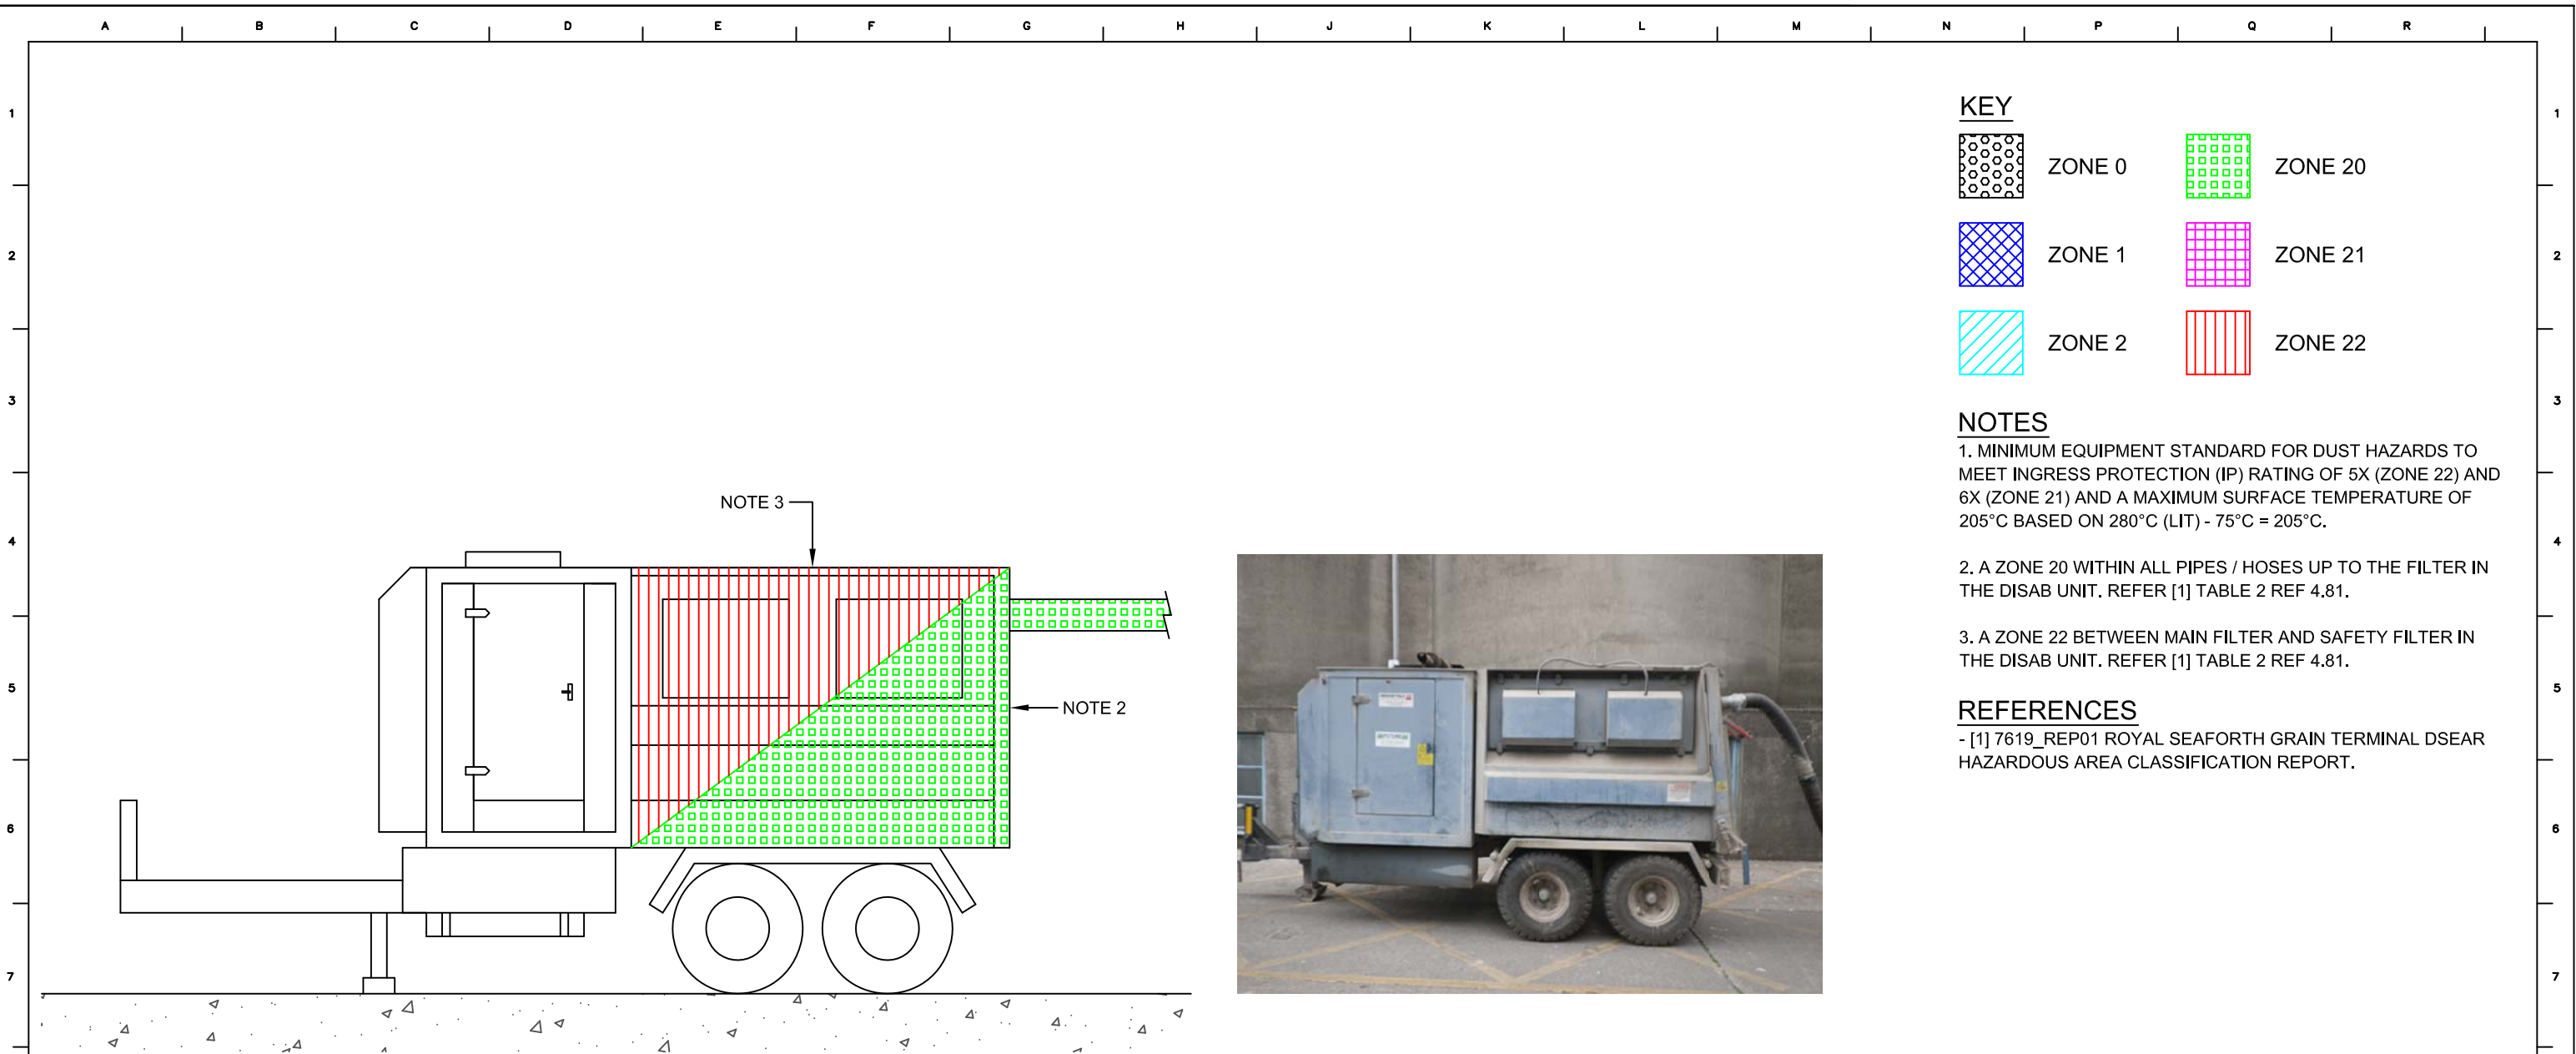

KEY

NOTES

1. MINIMUM EQUIPMENT STANDARD FOR DUST HAZARDS TO MEET INGRESS PROTECTION (IP) RATING OF 5X (ZONE 22) AND 6X (ZONE 21) AND A MAXIMUM SURFACE TEMPERATURE OF 205°C BASED ON 280°C (LIT) - 75°C = 205°C.

2. A ZONE 20 WITHIN ALL PIPES / HOSES UP TO THE FILTER IN THE DISAB UNIT. REFER [1] TABLE 2 REF 4.81.

3. A ZONE 22 BETWEEN MAIN FILTER AND SAFETY FILTER IN THE DISAB UNIT. REFER [1] TABLE 2 REF 4.81.

REFERENCES

- [1] 7619_REP01 ROYAL SEAFORTH GRAIN TERMINAL DSEAR
HAZARDOUS AREA CLASSIFICATION REPORT.

REVISION	A
DATE	15/06/20
DESCRIPTION	AS BUILT
AUTHOR	HR
CHECKED	SDO
APPROVED	AW



**INGLEWOOD ENGINEERING
CONSULTANCY LTD**
SYCAMORE HOUSE,
SPRINGWOOD WAY,
TYTHERINGTON BUSINESS PARK,
MACCLESFIELD, CHESHIRE,
SK10 2ND, 01625 410100
INFO@INGLEWOODENGINEERING.COM

PROJECT			
DSEAR AREA CLASSIFICATION			
IEC PROJECT No. 7840			
IEC DRAWING No. 7840-73-00021			
SCALE	DRAWN	H. RAZA	DATE 15/06/20
NTS @ A3	CHECKED	S. OWEN	DATE 29/06/20
	APPROVED	A. WOOD	DATE 09/07/20

TITLE ROYAL SEAFORTH GRAIN TERMINAL DISAB DUST COLLECTION AREA CLASSIFICATION DRAWING		
DRAWING No.	SHT No.	REV.
7840-73-00021		A