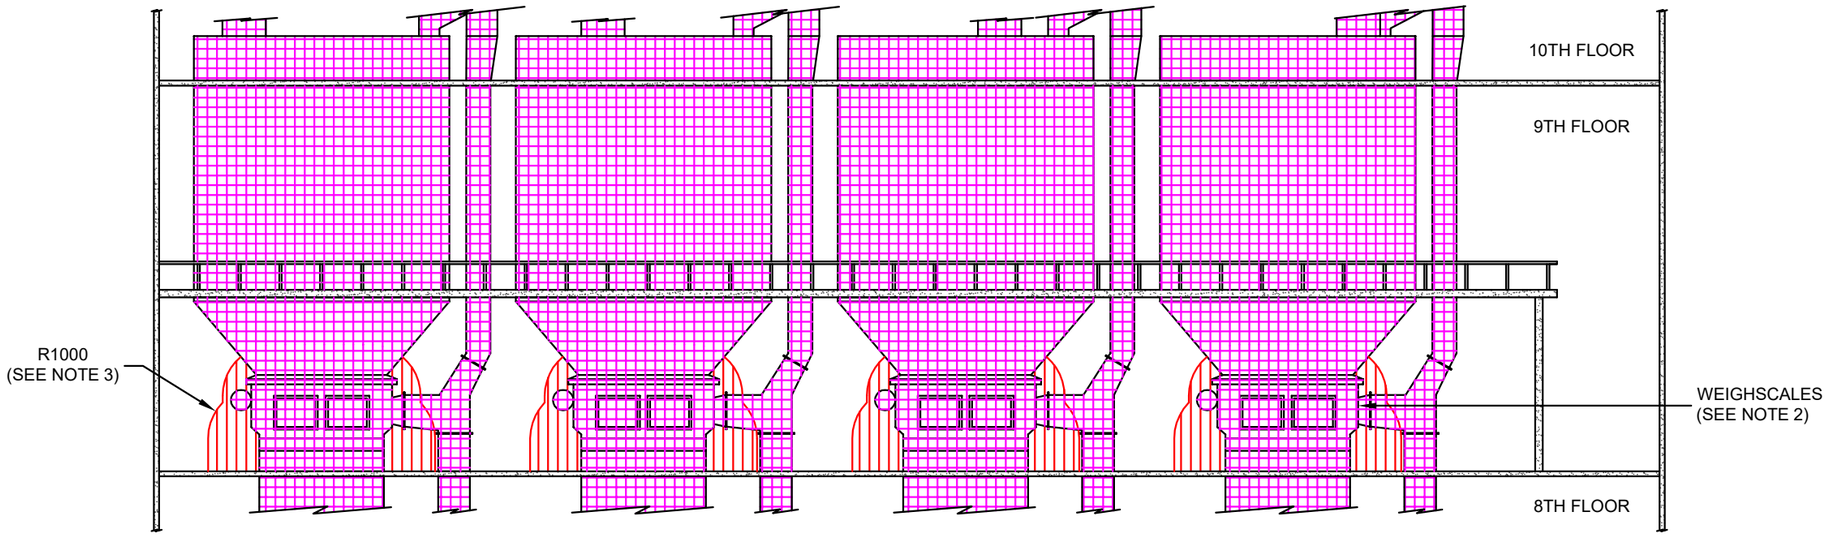

ELEVATION ON A-A

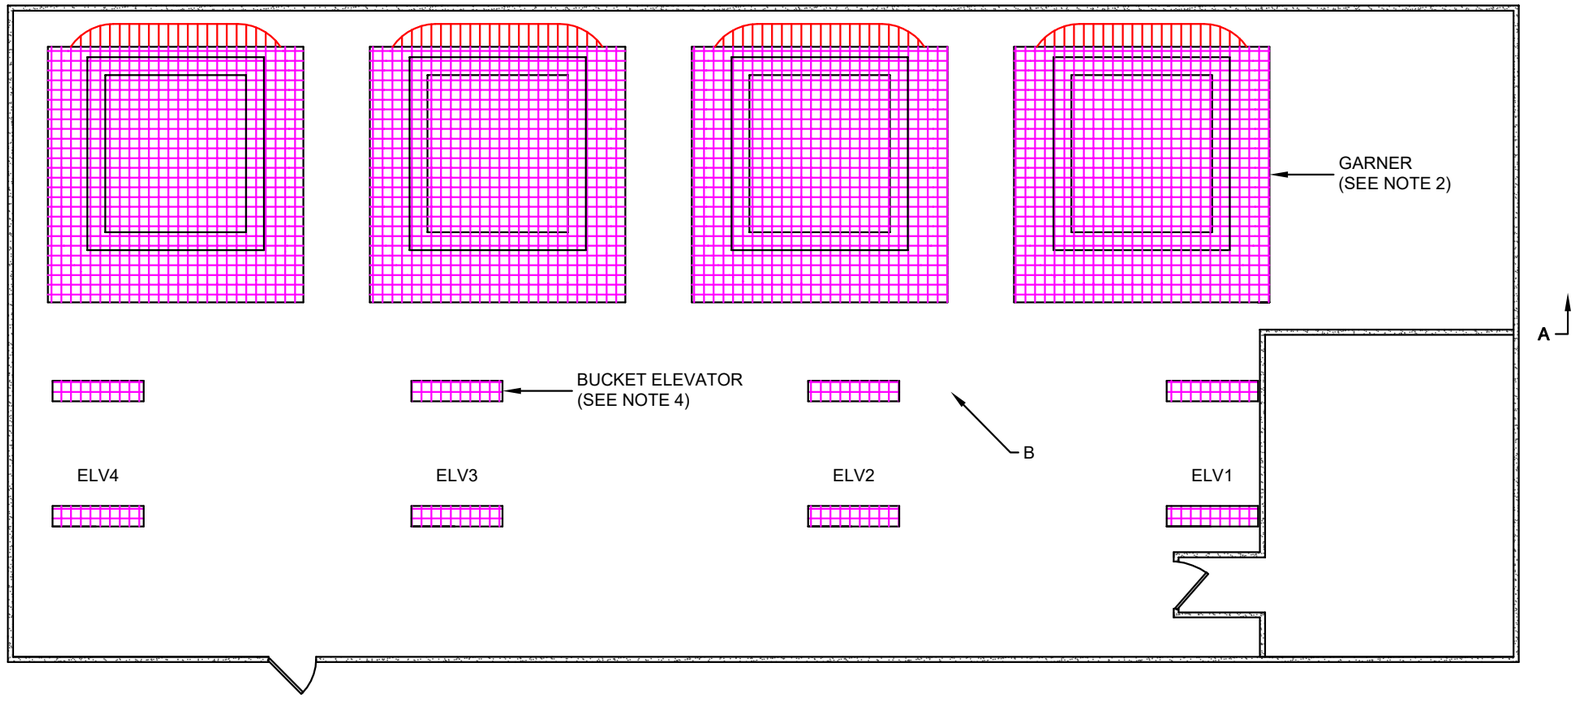

KEY

- ZONE 0
- ZONE 1
- ZONE 2
- ZONE 20
- ZONE 21
- ZONE 22

NOTES

1. MINIMUM EQUIPMENT STANDARD FOR DUST HAZARDS TO MEET INGRESS PROTECTION (IP) RATING OF 5X (ZONE 22) AND 6X (ZONE 21) AND A MAXIMUM SURFACE TEMPERATURE OF 205°C BASED ON 280°C (LIT) - 75°C = 205°C.

2. A BLANKET ZONE 21 WITHIN THE GARNER AND WEIGHSCALES. REFER [1] TABLE 2 REF 4.30.

3. A ZONE 22 OF A 1m RADIUS DOWN TO GROUND FROM ALL HATCHES AND SKIRTS. REFER [1] TABLE 2 REF 4.30.

4. A ZONE 21 WITHIN THE BUCKET ELEVATOR. REFER [1] TABLE 2.

REFERENCES

- [1] 7619_REP01 ROYAL SEAFORTH GRAIN TERMINAL DSEAR HAZARDOUS AREA CLASSIFICATION REPORT.

VIEW ON B

REVISION	A
DATE	15/06/20
DESCRIPTION	AS BUILT
AUTHOR	HR
CHECKED	SDO
APPROVED	AW

INGLEWOOD ENGINEERING CONSULTANCY LTD
SYCAMORE HOUSE,
SPRINGWOOD WAY,
TYTHERINGTON BUSINESS PARK,
MACCLESFIELD, CHESHIRE,
SK10 2ND, 01625 410100
INFO@INGLEWOODENGINEERING.COM

PROJECT	DSEAR AREA CLASSIFICATION		
IEC PROJECT No. 7840			
IEC DRAWING No. 7840-73-00011			
SCALE NTS @ A3	DRAWN H. RAZA	DATE 15/06/20	
	CHECKED S. OWEN	DATE 29/06/20	
	APPROVED A. WOOD	DATE 09/07/20	

TITLE: ROYAL SEAFORTH GRAIN TERMINAL WORKHOUSE 9TH FLOOR AREA CLASSIFICATION DRAWING

DRAWING No. 7840-73-00011 SHT No. REV. A