


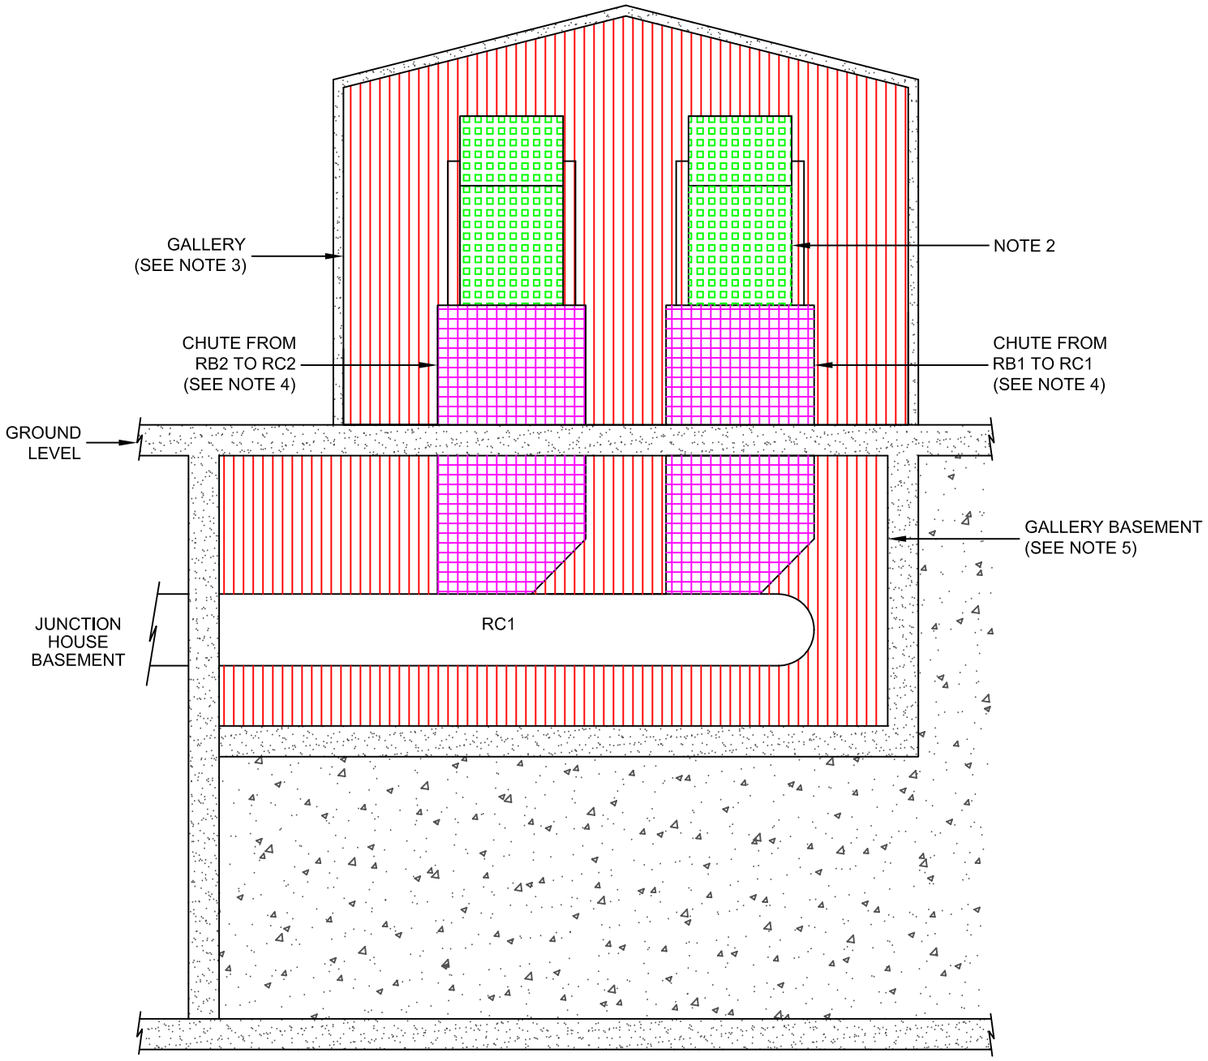


VIEW ON END OF GALLERY



VIEW OF GALLERY BASEMENT

## KEY

| | |
|---|---|
| ZONE 0 | ZONE 20 |
| ZONE 1 | ZONE 21 |
| ZONE 2 | ZONE 22 |

## NOTES

1. MINIMUM EQUIPMENT STANDARD FOR DUST HAZARDS TO MEET INGRESS PROTECTION (IP) RATING OF 5X (ZONE 22) AND 6X (ZONE 21) AND A MAXIMUM SURFACE TEMPERATURE OF 205°C BASED ON 280°C (LIT) - 75°C = 205°C.

2. A ZONE 20 INTERNALLY UP TO THE FILTER MEDIUM AND A ZONE 21 WHERE FINES ARE DISLODGED AND FALL BACK TO THE CONVEYOR. REFER [1] TABLE 2.

3. A BLANKET ZONE 22 WITHIN THE GALLERY. REFER [1] TABLE 2.

4. A ZONE 21 WITHIN DISCHARGE CHUTES FROM RB1 TO RC1 & RB2 TO RC2. REFER [1] TABLE 2.

5. A BLANKET ZONE 22 WITHIN THE GALLERY BASEMENT. REFER [1] TABLE 2.

## REFERENCES

- [1] 7619_REP01 ROYAL SEAFORTH GRAIN TERMINAL DSEAR HAZARDOUS AREA CLASSIFICATION REPORT.

| | |
|---|---|
| REVISION | A |
| DATE | 15/06/20 |
| DESCRIPTION | AS BUILT |
| AUTHOR | HR |
| CHECKED | SDO |
| APPROVED | AW |

INGLEWOOD ENGINEERING CONSULTANCY LTD
SYCAMORE HOUSE,
SPRINGWOOD WAY,
TYTHERINGTON BUSINESS PARK,
MACCLESFIELD, CHESHIRE,
SK10 2ND, 01625 410100
INFO@INGLEWOODENGINEERING.COM

| | | | |
|---|---|---|---|
| PROJECT | DSEAR AREA CLASSIFICATION | | |
| IEC PROJECT No. 7840 | | | |
| IEC DRAWING No. 7840-73-00002 | | | |
| SCALE NTS @ A3 | DRAWN H. RAZA | DATE 15/06/20 | |
| | CHECKED S. OWEN | DATE 29/06/20 | |
| | APPROVED A. WOOD | DATE 09/07/20 | |

| | | |
|---|---|---|
| TITLE | ROYAL SEAFORTH GRAIN TERMINAL JETTY GALLERY AREA CLASSIFICATION DRAWING | |
| DRAWING No. | SHT No. | REV. |
| 7840-73-00002 | | A |