


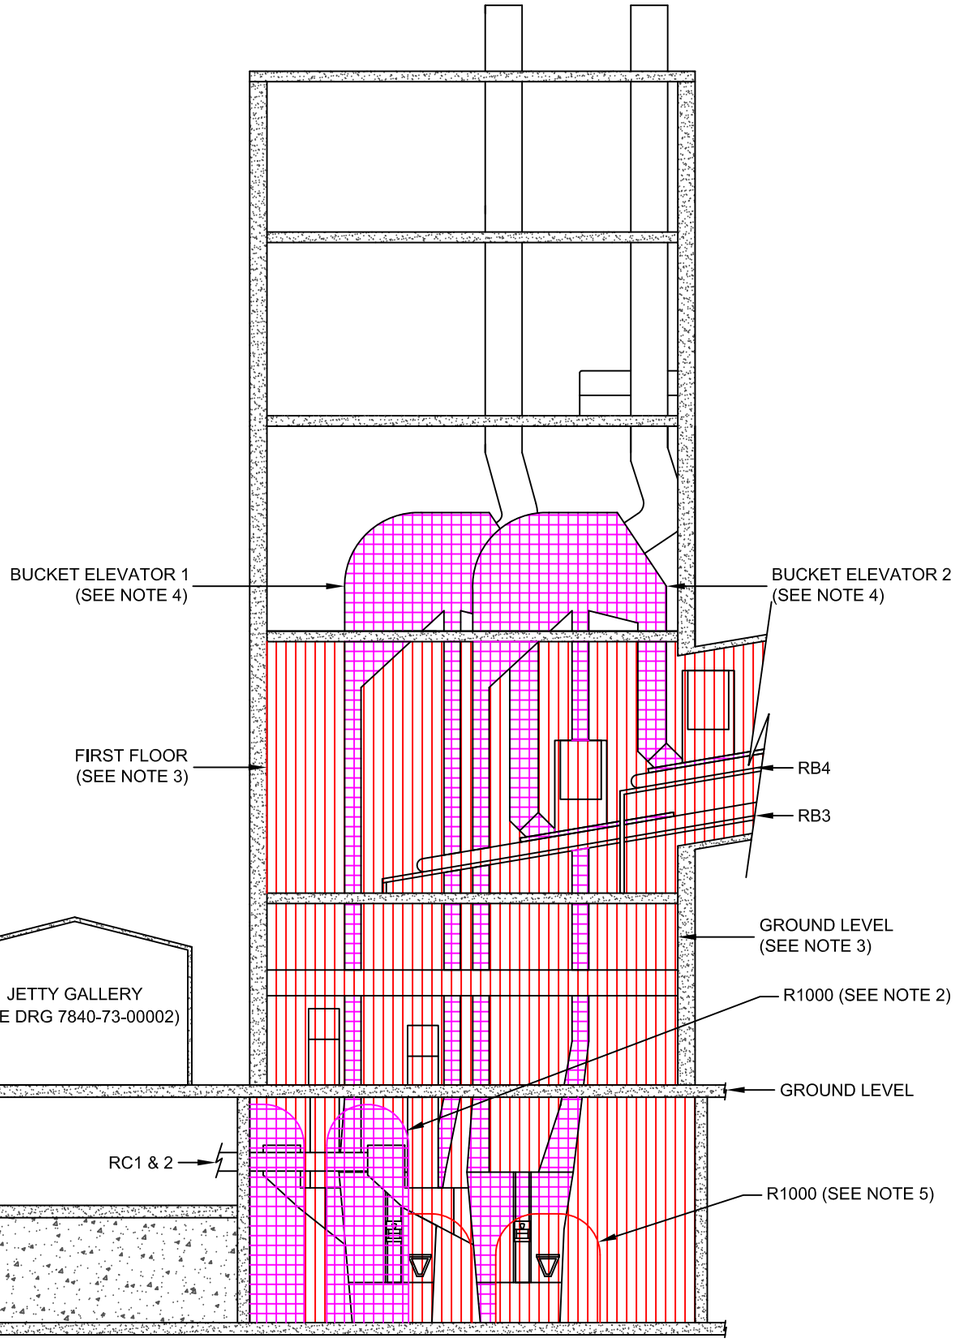

SECOND FLOOR VIEW



FIRST FLOOR VIEW



GROUND FLOOR VIEW



BASEMENT VIEW

KEY

- ZONE 0
- ZONE 20
- ZONE 1
- ZONE 21
- ZONE 2
- ZONE 22

NOTES

1. MINIMUM EQUIPMENT STANDARD FOR DUST HAZARDS TO MEET INGRESS PROTECTION (IP) RATING OF 5X (ZONE 22) AND 6X (ZONE 21) AND A MAXIMUM SURFACE TEMPERATURE OF 205°C BASED ON 280°C (LIT) - 75°C = 205°C.

2. A ZONE 21 OF A 1m RADIUS DOWN TO GROUND FROM WHERE THE CONVEYORS DISCHARGE TO THE BUCKET ELEVATOR. REFER [1] TABLE 2 REF 4.12.

3. A BLANKET ZONE 22 IN ALL AREAS BENEATH THE TOP FLOOR. REFER [1] TABLE 2 REF 4.15.

4. A ZONE 21 WITHIN BUCKET ELEVATOR. REFER [1] TABLE 2.

5. A ZONE 22 OF A 1m RADIUS DOWN TO GROUND FROM HOUSEKEEPING / INSPECTION HATCHES. REFER [1] TABLE 2.

REFERENCES

- [1] 7619_REP01 ROYAL SEAFORTH GRAIN TERMINAL DSEAR HAZARDOUS AREA CLASSIFICATION REPORT.

REVISION	A
DATE	15/06/20
DESCRIPTION	AS BUILT
AUTHOR	SDO
CHECKED	SDO
APPROVED	AW

INGLEWOOD ENGINEERING CONSULTANCY LTD
SYCAMORE HOUSE,
SPRINGWOOD WAY,
TYTHERINGTON BUSINESS PARK,
MACCLESFIELD, CHESHIRE,
SK10 2ND, 01625 410100
INFO@INGLEWOODENGINEERING.COM

PROJECT
DSEAR AREA CLASSIFICATION
IEC PROJECT No. 7840
IEC DRAWING No. 7840-73-00003

SCALE			
NTS @ A3	DRAWN	S. OWEN	DATE 15/06/20
	CHECKED	S. OWEN	DATE 29/06/20
	APPROVED	A. WOOD	DATE 09/07/20

TITLE
ROYAL SEAFORTH GRAIN TERMINAL
JUNCTION HOUSE
AREA CLASSIFICATION DRAWING

DRAWING No. 7840-73-00003 SHT No.

REV. A