


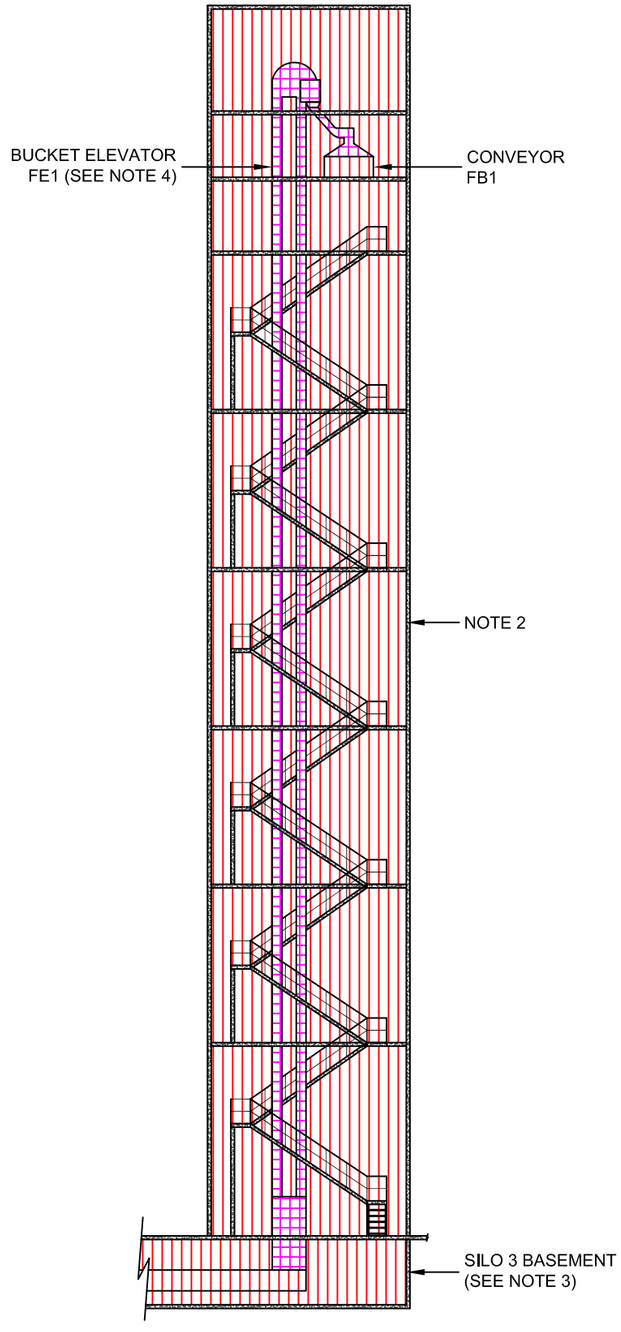

VIEW OF FE1 BUCKET ELEVATOR
& CONVEYOR FB1

KEY

- ZONE 0
- ZONE 20
- ZONE 1
- ZONE 21
- ZONE 2
- ZONE 22

NOTES

1. MINIMUM EQUIPMENT STANDARD FOR DUST HAZARDS TO MEET INGRESS PROTECTION (IP) RATING OF 5X (ZONE 22) AND 6X (ZONE 21) AND A MAXIMUM SURFACE TEMPERATURE OF 205°C BASED ON 280°C (LIT) - 75°C = 205°C.

2. A BLANKET ZONE 22 THROUGHOUT THE FEED ELEVATOR TOWER BUILDING. REFER [1] TABLE 2, REF 4.69.

3. A BLANKET ZONE 22 THROUGHOUT THE BASEMENT. REFER [1] TABLE 2, REF 4.68.

4. A ZONE 21 WITHIN THE BUCKET ELEVATOR. REFER [1] TABLE 2.

REFERENCES

- [1] 7619_REP01 ROYAL SEAFORTH GRAIN TERMINAL DSEAR HAZARDOUS AREA CLASSIFICATION REPORT.

REVISION	A
DATE	15/06/20
DESCRIPTION	AS BUILT
AUTHOR	SDO
CHECKED	SDO
APPROVED	AW

INGLEWOOD ENGINEERING CONSULTANCY LTD
SYCAMORE HOUSE,
SPRINGWOOD WAY,
TYTHERINGTON BUSINESS PARK,
MACCLESFIELD, CHESHIRE,
SK10 2ND, 01625 410100
INFO@INGLEWOODENGINEERING.COM

PROJECT	DSEAR AREA CLASSIFICATION		
IEC PROJECT No. 7840			
IEC DRAWING No. 7840-73-00007			
SCALE NTS @ A3	DRAWN S. OWEN	DATE 15/06/20	
	CHECKED S. OWEN	DATE 29/06/20	
	APPROVED A. WOOD	DATE 09/07/20	

TITLE	ROYAL SEAFORTH GRAIN TERMINAL SILO 3 TOWER ELEVATION AREA CLASSIFICATION DRAWING	
DRAWING No. 7840-73-00007	SHT No.	REV. A