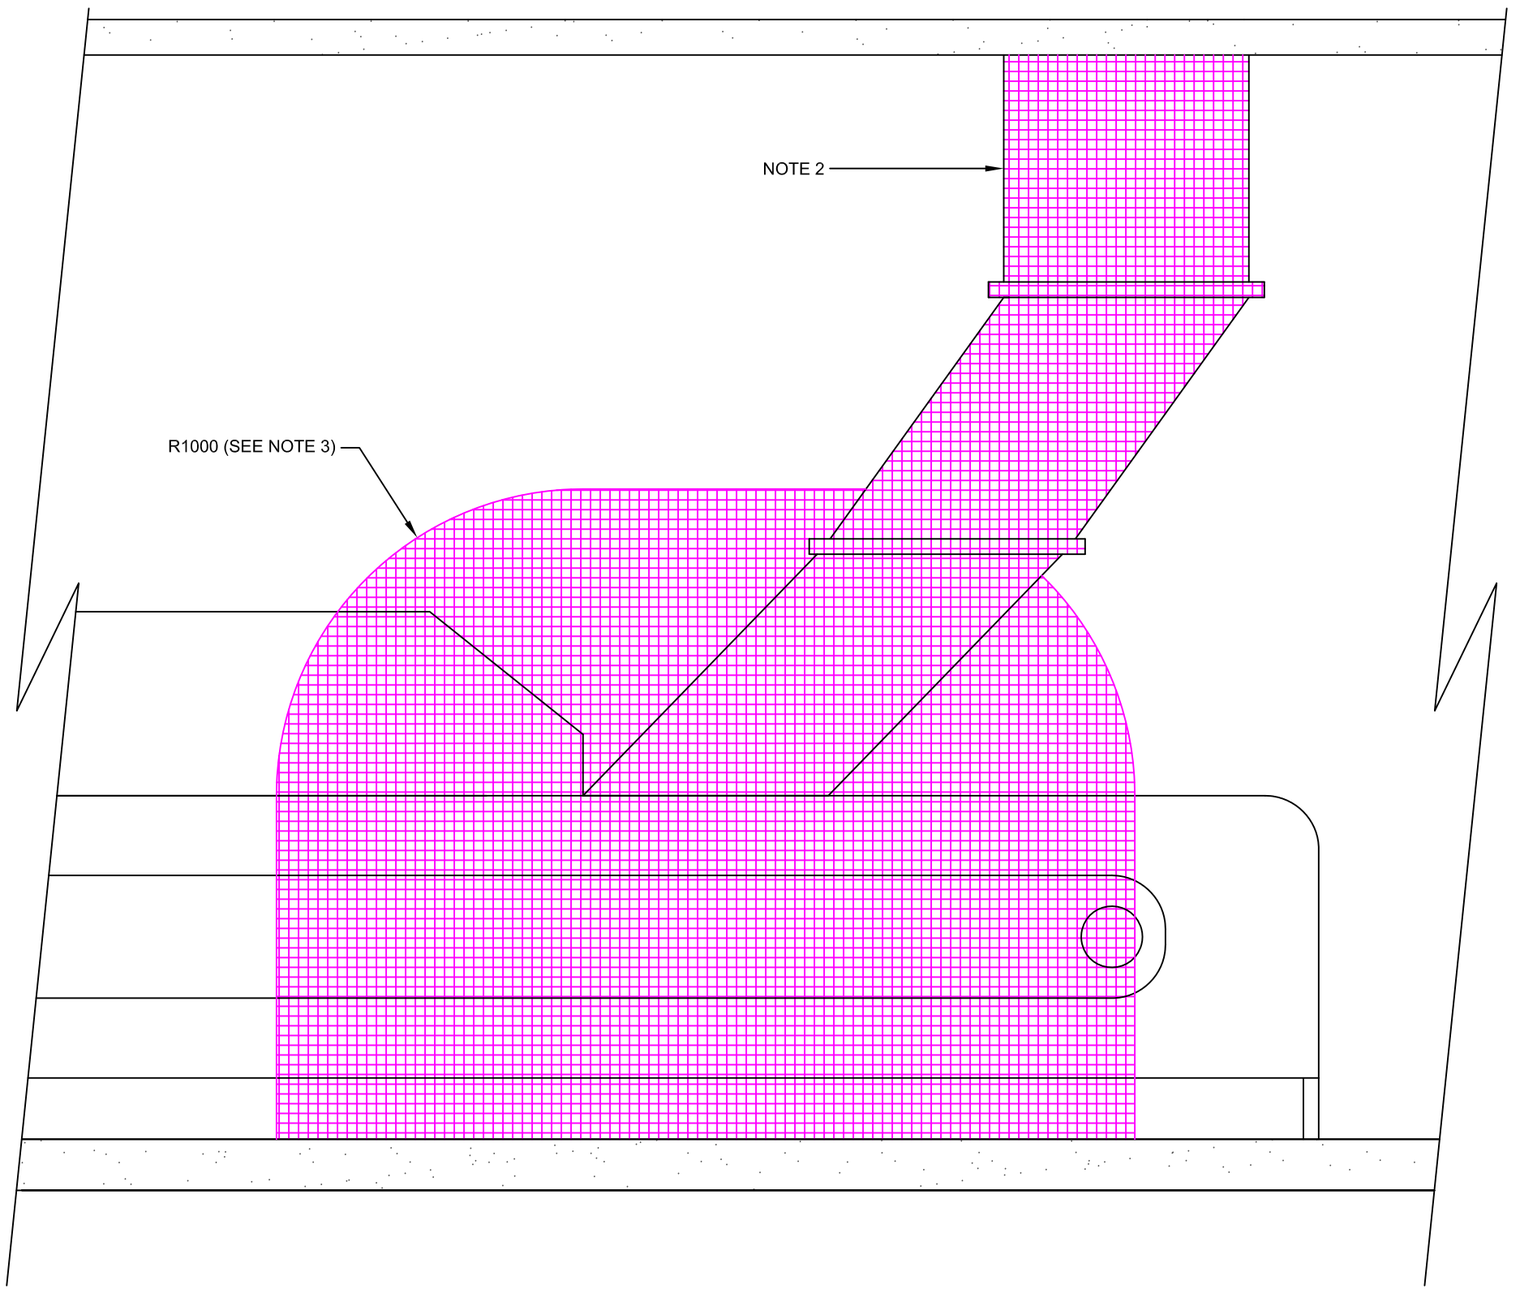


KEY

ZONE 0	ZONE 20
ZONE 1	ZONE 21
ZONE 2	ZONE 22

NOTES

1. MINIMUM EQUIPMENT STANDARD FOR DUST HAZARDS TO MEET INGRESS PROTECTION (IP) RATING OF 5X (ZONE 22) AND 6X (ZONE 21) AND A MAXIMUM SURFACE TEMPERATURE OF 205°C BASED ON 280°C (LIT) - 75°C = 205°C.

2. A ZONE 21 WITHIN THE DISCHARGE CHUTES. REFER [1] TABLE 2.

3. A ZONE 21 OF A 1m RADIUS DOWN TO GROUND FROM DISCHARGE CHUTES. REFER [1] TABLE 2.

REFERENCES

- [1] 7619_REP01 ROYAL SEAFORTH GRAIN TERMINAL DSEAR HAZARDOUS AREA CLASSIFICATION REPORT.

REVISION	A
DATE	15/06/20
DESCRIPTION	AS BUILT
AUTHOR	HR
CHECKED	SDO
APPROVED	AW

INGLEWOOD ENGINEERING CONSULTANCY LTD
SYCAMORE HOUSE,
SPRINGWOOD WAY,
TYTHERINGTON BUSINESS PARK,
MACCLESFIELD, CHESHIRE,
SK10 2ND, 01625 410100
INFO@INGLEWOODENGINEERING.COM

PROJECT	DSEAR AREA CLASSIFICATION		
IEC PROJECT No. 7840			
IEC DRAWING No. 7840-73-00024			
SCALE NTS @ A3	DRAWN H. RAZA	DATE 15/06/20	
	CHECKED S. OWEN	DATE 29/06/20	
	APPROVED A. WOOD	DATE 09/07/20	

TITLE
ROYAL SEAFORTH GRAIN TERMINAL
GENERIC DISCHARGE CHUTE
AREA CLASSIFICATION DRAWING

DRAWING No. 7840-73-00024 SHT No.

REV. A