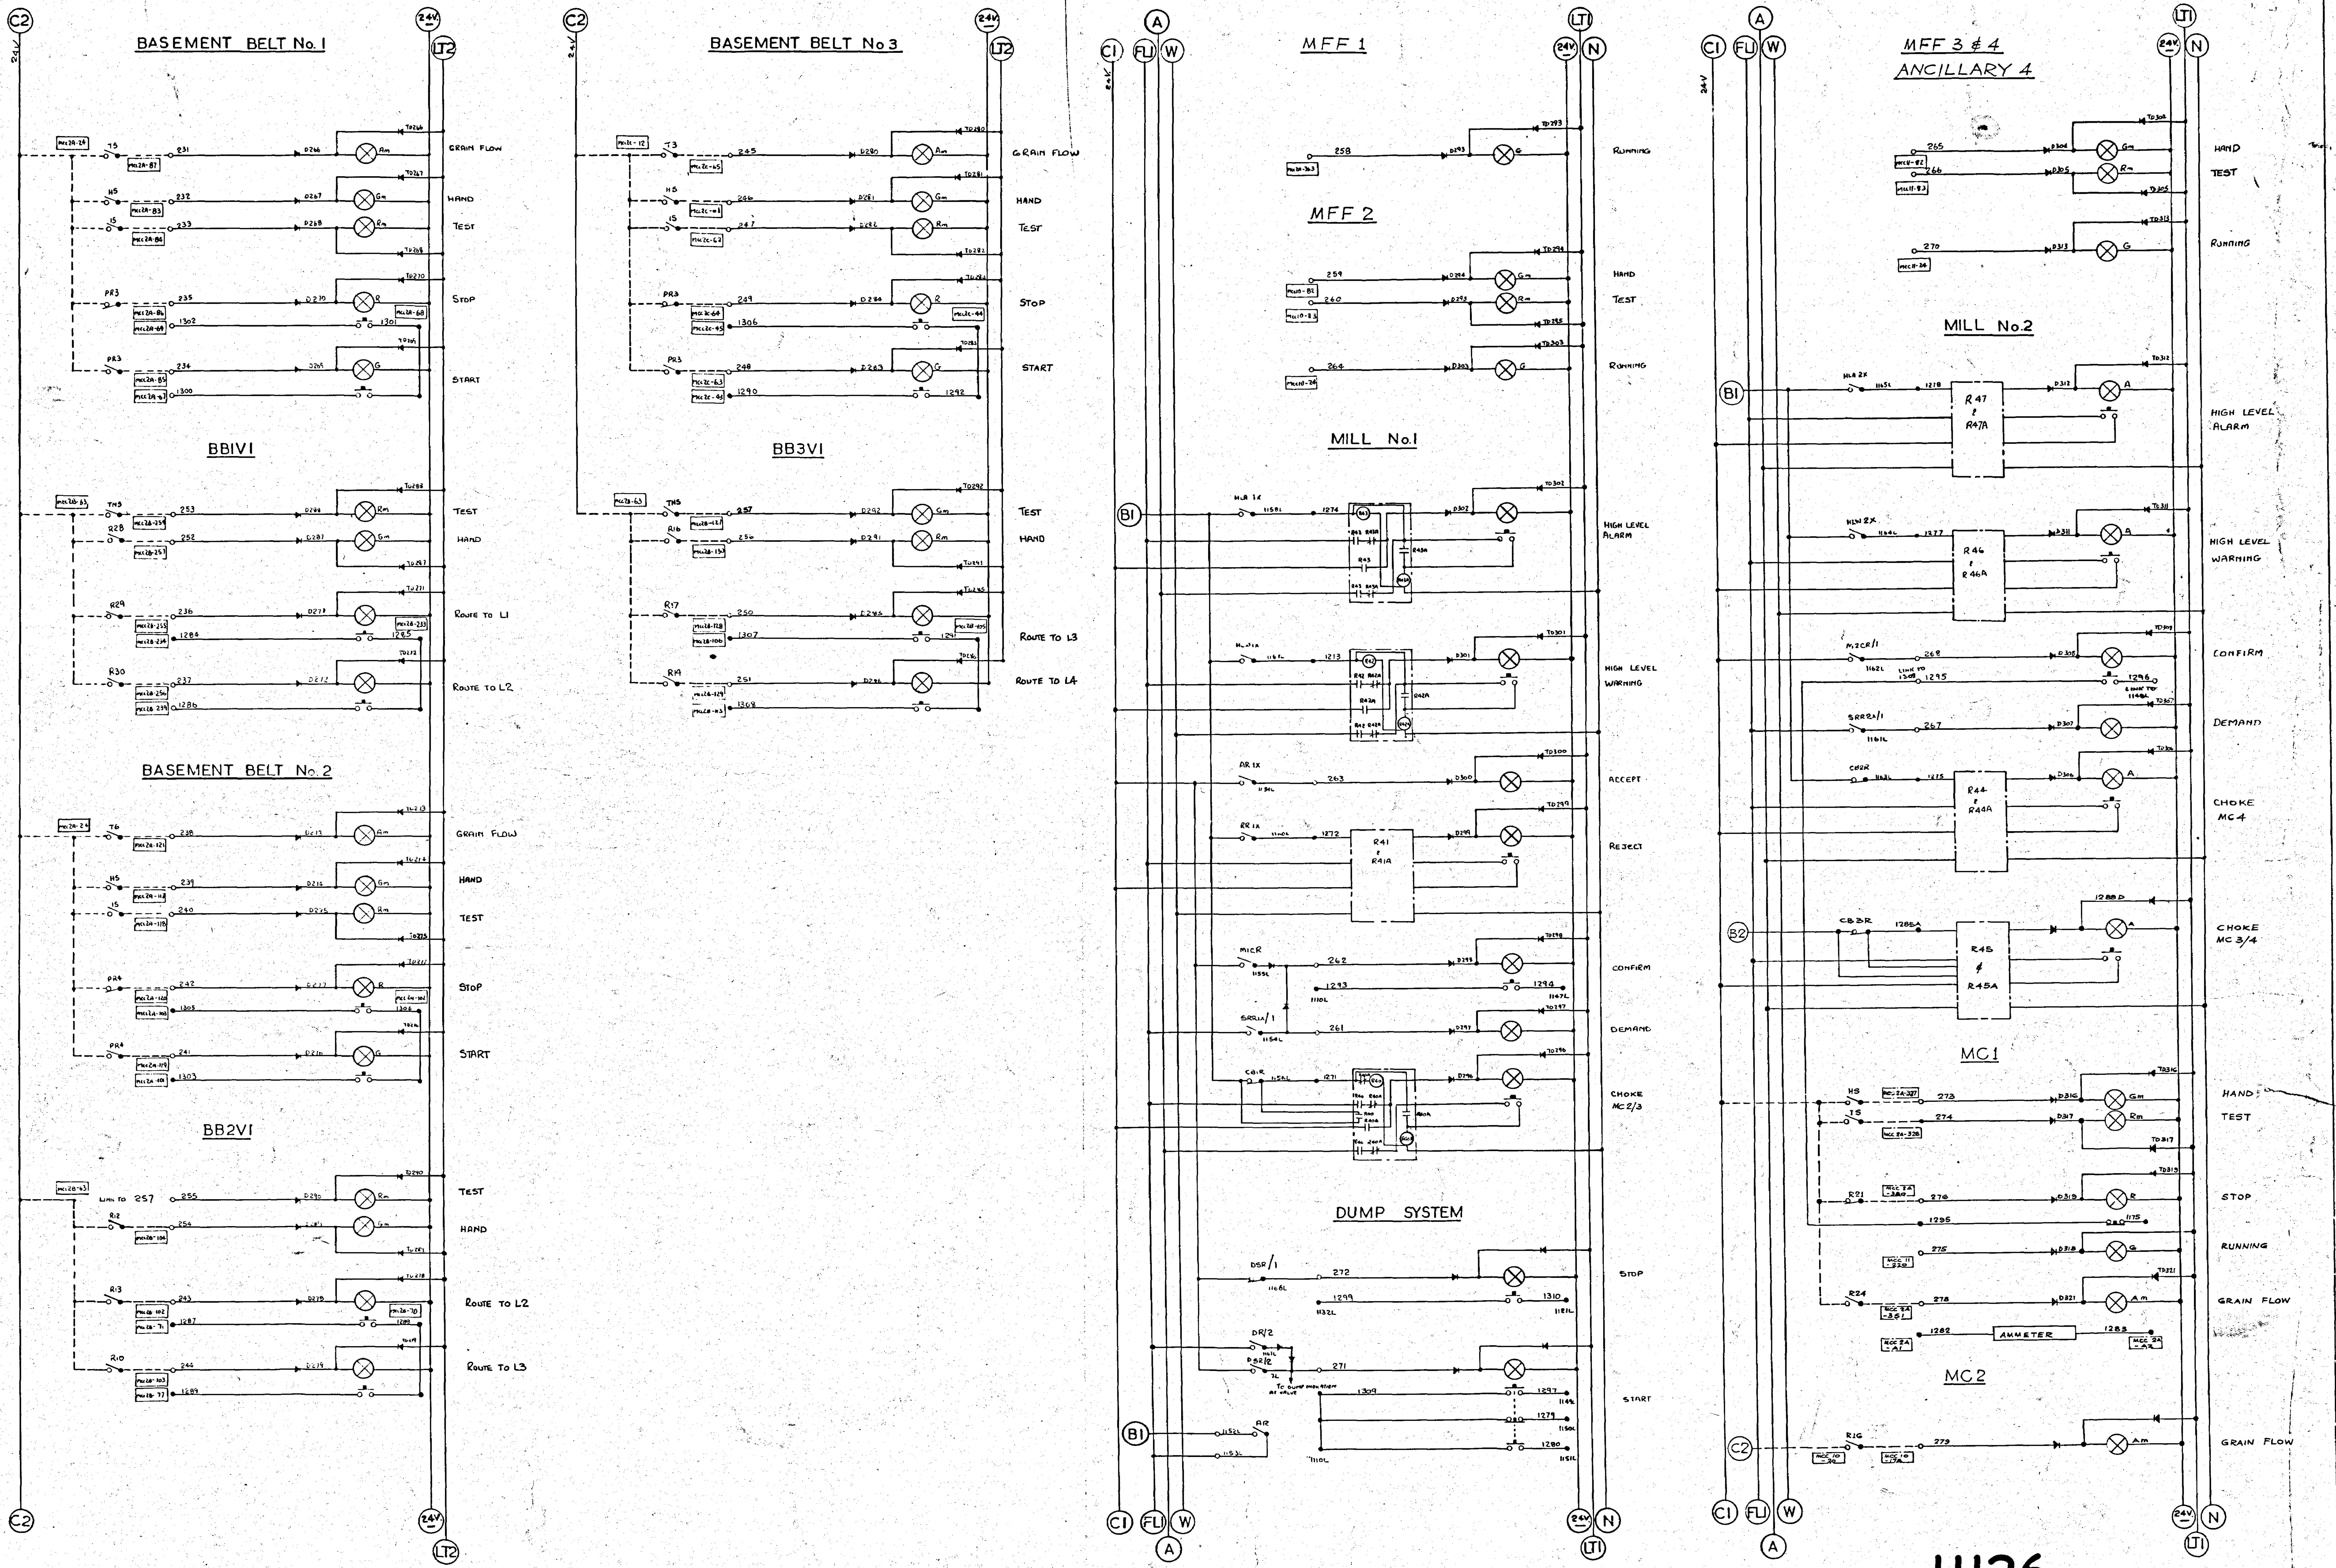


11136

THE DESIGN AND MANUFACTURING INFORMATION CONTAINED IN THIS DRAWING IS THE EXCLUSIVE RIGHT OF DEWHURST & PARTNER LTD. AND MUST NOT BE COPIED OR USED FOR MANUFACTURING PURPOSES.

ISSUE ~~1~~ ~~2~~ ~~3~~ 4

SCHEMATIC DIAGRAM FOR SUPERVISORY CONTROL PANEL
SHEET 9 OF 12

DEWHURST & PARTNER LTD.
MELBOURNE WORKS HOUNSLOW

TITLE: SCHEMATIC DIAGRAM FOR SUPERVISORY CONTROL PANEL - SEAFORTH GRAIN TERMINAL

REVISION :	REVISION :	REVISION : 3	REVISION : 2	REVISION : 1
		DP 3,10,11 REMOVED MFF 1,2,3/4, ADDED SITE MOD.	CHOKE CIRCUIT & RELAYS R45 & R45A ADDED FOR MC 3/4 SITE MOD.	MILL WIRING MODIFIED.
ORIGIN : / / SGD.	ORIGIN : / / SGD.	ORIGIN : 18/9/75 SGD. EP.	ORIGIN : 6/6/75 SGD. EP.	ORIGIN : 1CD 16/3/73 SGD.

DRAWN BY	[signature]
DATE	5/1/73
CHECKED BY	
APPROVED BY	
DATE	

KEY DIAG. No.
EXT. DIAG. No.
REL. DIAG. No.
PANEL LAYOUT No.

DTX 361 AR/9