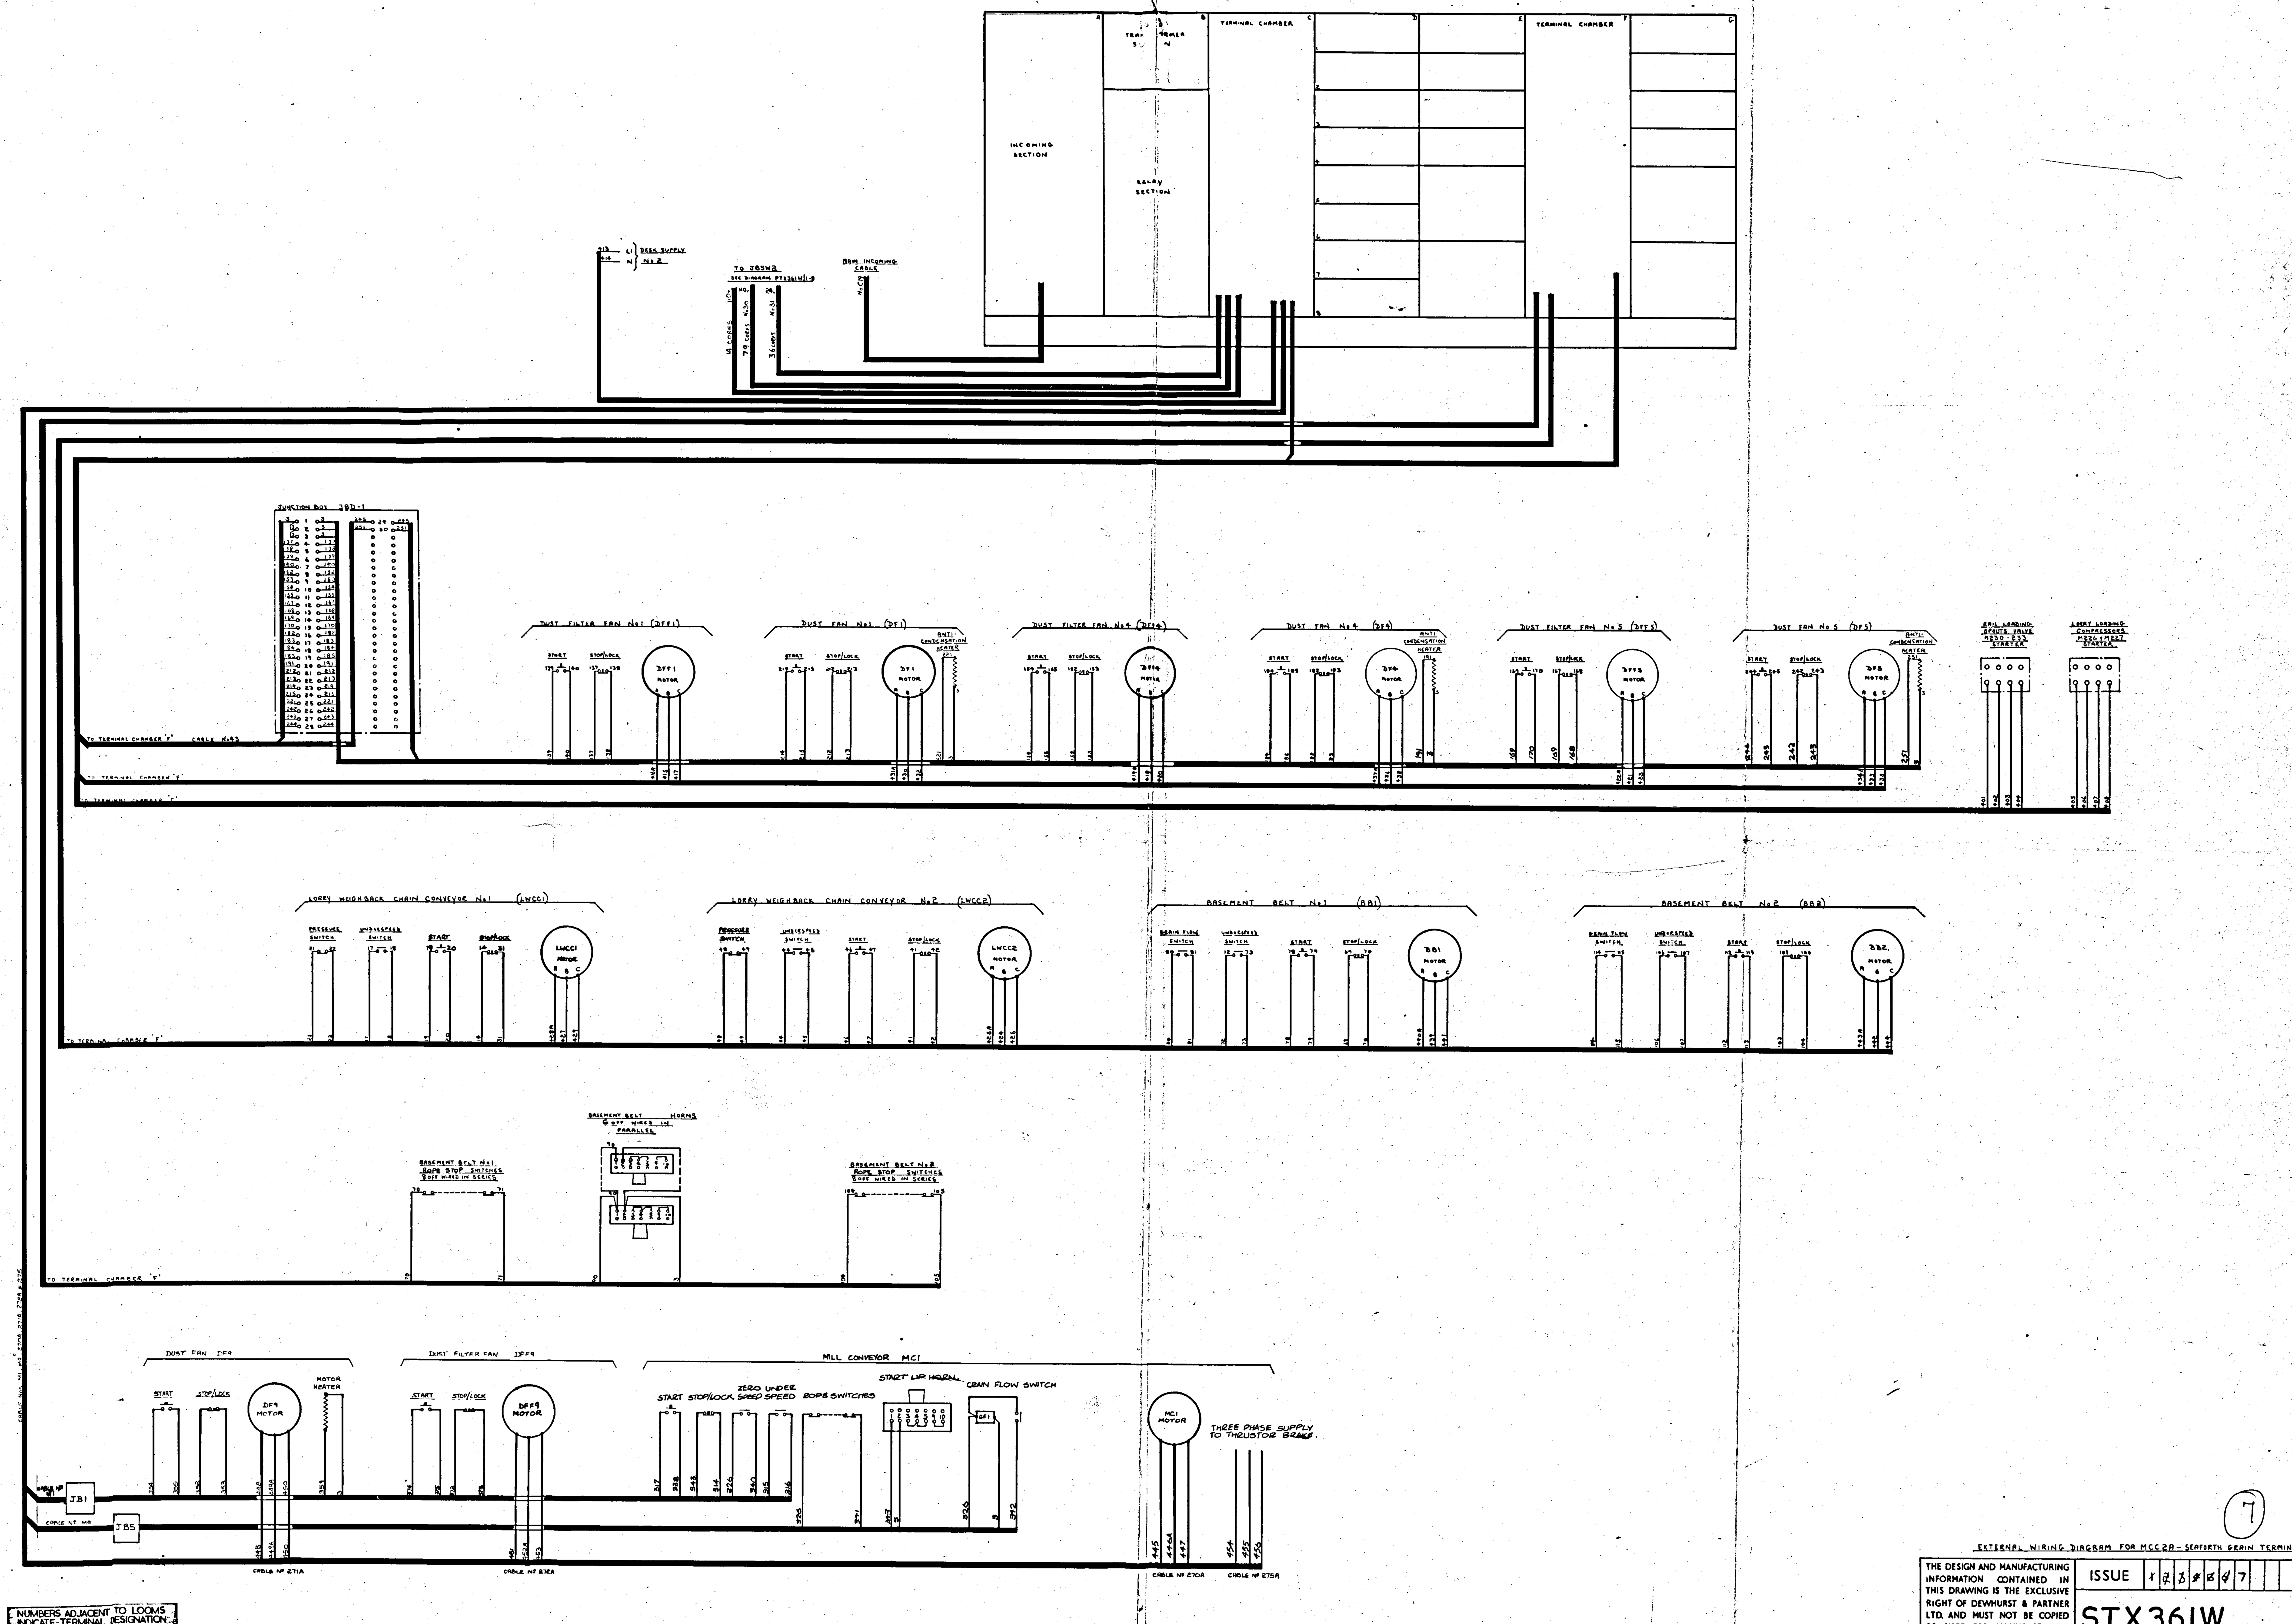

EXTERNAL WIRING DIAGRAM FOR MCC2A – SEAFORTH GRAIN TERMINAL

(7)

THE DESIGN AND MANUFACTURING INFORMATION CONTAINED IN THIS DRAWING IS THE EXCLUSIVE RIGHT OF DEWHURST & PARTNER LTD. AND MUST NOT BE COPIED OR USED FOR MANUFACTURING PURPOSES.

ISSUE ~~1~~ ~~2~~ ~~3~~ ~~4~~ ~~5~~ ~~6~~ 7

STX361W

Revision: 6	Revision: 5	Revision: 4	Revision: 3	Revision: 2	Revision: 1
MILL FEED CONNECTIONS MODIFIED.	DF9, DFF9 & MC1 ADDED	14 CORE CABLE TO JBSW2 ADDED.	BASEMENT BELT No2 HORNS REMOVED. BASEMENT BELT HORNS NOW COMMON TO BB1 BB2 & BB3. ROPE SWITCH TITLES MODIFIED.	No of 24v CORES WERE 42	ISSUE 1 DES. No ADDED. CABLE No 30 CORES WERE 19
ORIGIN: ICD 17/8/72 JS	ORIGIN: ICD 15/6/72 SGD.	ORIGIN: CUST. 8/5/72 SGD.	ORIGIN: CUST. 29/4/71 SGD. J.T.	ORIGIN: CUST 9/2/71 SGD	ORIGIN: E&P 26/1/71 SGD

DRAWN BY	
DATE	22-12-70
CHECKED BY	
APPROVED BY	
DATE	

KEY DIAG. No.	DTX361W/1-2
EXT. DIAG. No.	—
REL. DIAG. No.	
PANEL LAYOUT No.	HTX361W

STX361W

DEWHURST & PARTNER LTD.

MELBOURNE WORKS HOUNSLOW

TITLE: EXTERNAL WIRING DIAGRAM FOR MCC2A – SEAFORTH GRAIN TERMINAL